

MISSISSIPPI DEPARTMENT OF NATURAL RESOURCES

Bureau of Land and Water Resources

Southport Mall

P.O. Box 10631

Jackson, Mississippi 39209

WATER WELL DRILLERS LOG

Date  
        
        
        
      

date well completed 7-1 19 82 county well located Tate

HICKS WELL CO.  
 Rt. 1, Box 157  
 Senatobia, MS 38668

LANDOWNER: Douglas Fisher  
Rt. 1 Box 246A  
Senatobia, Miss. 38668  
 (mailing address)

description of formations encountered	from	to
<u>Red Clay</u>	<u>0</u>	<u>15</u>
<u>Red Sand</u>	<u>15</u>	<u>50</u>
<u>white sand + clay</u>	<u>50</u>	<u>85</u>
<u>white sand</u>	<u>85</u>	<u>140</u>

WELL LOCATION:  
 sec 26 T 5 N R 6 E  
1 miles W of Bam  
 (distance) (direction) (nearest town)

WELL PURPOSE: Home  
 (home, irrigation, municipal, industrial)

WELL COMPLETION DATA:

(1) diameter (inches) 4

(2) total depth (feet) 140

(3) static water level (feet) 80 below top of ground. above

(4) casing PVC, 140,  
 (material) (depth)

4' if telescope see back.  
 (size)

(5) screen 17, 133  
 (length) (depth to top)

02, PVC + gravel  
 (size) (material)

(6) pump 3/4, 10  
 (HP) (yield gpm)

220V  
 (type power)

(7) electric log No  
 (yes or no)

(organization running log)

(8) how well bottom plugged Cap

DRILLERS REMARKS:  
        
        
      


DEPT. OF NATURAL RESOURCES  
 BUREAU OF LAND & WATER RESOURCES

AUG - 4 1982

RECEIVED

If well telescopes please sketch and show depths.

GROUND LEVEL

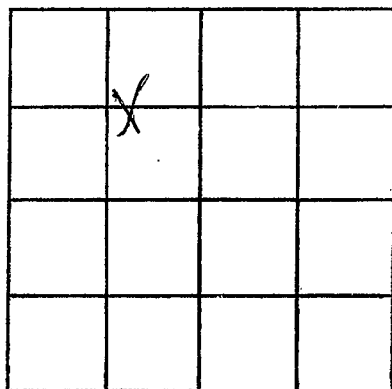

SECTION 26

Please indicate well location X.

ADDITIONAL INFORMATION

If more than one screen,  
show locations of each on sketch.