

MISSISSIPPI DEPARTMENT OF NATURAL RESOURCES

Bureau of Land and Water Resources

Southport Mall

P.O. Box 10631

Jackson, Mississippi 39209

WATER WELL DRILLERS LOG
HICKS WELL CO.

Rt. 1, Box 157

Senatobia, Miss. 38668

Date
H 2078

1-17 19 83
date well completed

TATE
county well located

LANDOWNER: Jerry Pipkin
Pt. 3
Senatobia, Mo. 38668
(mailing address)

description of formations encountered	from	to
Red Clay	0	10
Red sand	10	50
White sand	50	120
White Clay	120	125
White Sand	125	145

WELL LOCATION:
sec. 20 T 5 N R 6 E
(distance) miles (direction) of (nearest town)

WELL PURPOSE: Home
(home, irrigation, municipal, industrial)


- WELL COMPLETION DATA:
- (1) diameter (inches) 4
 - (2) total depth (feet) 145'
 - (3) static water level (feet) 50' below above top of ground.
 - (4) casing PVC 145' (material), (depth)
4" (size) if telescope see back.
 - (5) screen 10' 135' (length), (depth to top)
1 1/2" PVC (size), (material)
 - (6) pump 1/2 (HP) 10 (yield gpm)
220V (type power)
 - (7) electric log No (yes or no)
(organization running log)
 - (8) how well bottom plugged Cap

DRILLERS REMARKS:

DEPT. OF NATURAL RESOURCES
BUREAU OF LAND & WATER RESOURCES
MAR 28 1983
RECEIVED

If well telescopes please sketch and show depths.

GROUND LEVEL

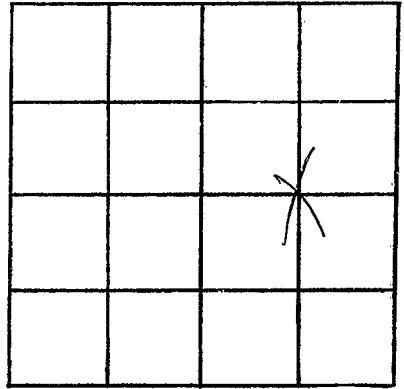

SECTION 20

Please indicate well location X.

ADDITIONAL INFORMATION

If more than one screen,
show locations of each on sketch.