

MISSISSIPPI DEPARTMENT OF NATURAL RESOURCES

Bureau of Land and Water Resources

Southport Mall

P.O. Box 10631

Jackson, Mississippi 39209

WATER WELL DRILLERS LOG

Date  
H 2007

1-18-83 date well completed  
NICKS WELL CO.  
Rt. 1, Box 157  
Senatobia, MS 38662  
Tate county well located

LANDOWNER:	description of formations encountered	from	to
Dwight Taylor Pct. 3	Red Clay	0	10
Senatobia, Miss 38662 (mailing address)	Red Sand	10	50
WELL LOCATION: sec. 20 T 5 N R 6 E	White Sand	50	120
2 miles NW Yorkblaw (distance) (direction) (nearest town)	White Clay	120	128
WELL PURPOSE: Home (home, irrigation, municipal, industrial)	White Sand	128	140

WELL COMPLETION DATA:

(1) diameter (inches) 4

(2) total depth (feet) 140

(3) static water level (feet) 50 below top of ground

(4) casing PVC, 140 (material) (depth)  
4" (size) if telescope see back.

(5) screen 10 (length) 30 (depth to top)  
073 (size) PVC (material)

(6) pump 1/2 (HP) 10 (yield gpm)  
220V (type power)

(7) electric log no (yes or no)

(organization running log)

(8) how well bottom plugged Cap

DEPT. OF NATURAL RESOURCES  
BUREAU OF LAND & WATER RESOURCES


MAR 28 1983

RECEIVED

DRILLERS REMARKS:

If well telescopes please sketch and show depths.

GROUND LEVEL

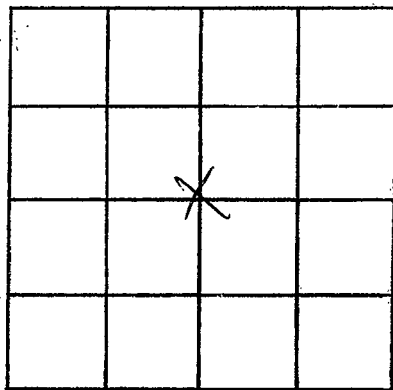

SECTION 20

Please indicate well location X.

ADDITIONAL INFORMATION

If more than one screen,  
show locations of each on sketch.