

MISSISSIPPI DEPARTMENT OF NATURAL RESOURCES

Bureau of Land and Water Resources

Southport Mall

P.O. Box 10631

Jackson, Mississippi 39209

WATER WELL DRILLERS LOG

Date
 H 2078

3-22 19 83 WICKS WELL CO
 date well completed Rt. 1, Box 157

Tate
 county well located

| LANDOWNER: J. H. Yates Rt. 1 Box 248 Sensation, Miss. (mailing address) 38668 | description of formations encountered | from | to |
|---|---------------------------------------|------|-----|
| | Red Clay | 0 | 20 |
| | Red Sand | 20 | 50 |
| WELL LOCATION: sec. 27 T 5 N R. 6 E ⑤ (W) 1 1/2 miles NE of Osprey (distance) (direction) (nearest town) | White sand & clay | 50 | 135 |
| | White sand | 135 | 155 |
| WELL PURPOSE: None (home, irrigation, municipal, industrial) | | | |
| WELL COMPLETION DATA: (1) diameter (inches) 4 (2) total depth (feet) 155 (3) static water level (feet) 80 below top of ground. (4) casing PVC 155 (material) (depth) 4" (size) If telescope see back. (5) screen 10 (length) 145 (depth to top) 813 (size) PVC (material) (6) pump 1/2 (HP) 10 (yield gpm) 220V (type power) (7) electric log No (yes or no) (organization running log) (8) how well bottom plugged Cap | | | |

DEPT. OF NATURAL RESOURCES
 BUREAU OF LAND & WATER RESOURCES


APR - 4 1983

RECEIVED

DRILLERS REMARKS:

If well telescopes please sketch and show depths.

GROUND LEVEL

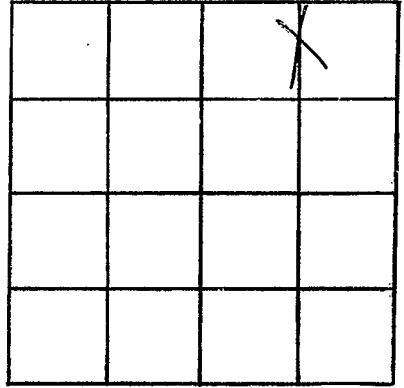

SECTION 27

Please indicate well location X.

ADDITIONAL INFORMATION

If more than one screen, show locations of each on sketch.