

MISSISSIPPI DEPARTMENT OF NATURAL RESOURCES

Bureau of Land and Water Resources

Southport Mall

P.O. Box 10631

Jackson, Mississippi 39209

WATER WELL DRILLERS LOG

Date  
 Hours

3-30 1983  
 date well completed

HICKS WELL CO.  
 Rt. 1 Box 157  
 Senatobia, MS 38668

Tate  
 county well located

LANDOWNER: Ricky Wooten  
 Rt. 2 Box 315  
 Coldwater, Miss. 38618  
 (mailing address)

description of formations encountered	from	to
Red Clay	0	20
Red Sand	20	35
Red Clay + Sand	35	65
White Clay + Sand	65	110
White Sand	110	140

WELL LOCATION:  
 sec. 11 T. 5 N. R. 6 E.  
 2 1/2 miles S of Independence  
 (distance) (direction) (nearest town)

WELL PURPOSE: Home  
 (home, irrigation, municipal, industrial)

- WELL COMPLETION DATA:
- (1) diameter (inches) 4
  - (2) total depth (feet) 140
  - (3) static water level (feet) 80 below above top of ground.
  - (4) casing PVC 140 (material) (depth)
  - (5) screen 4' (size) If telescope see back. 10' 130 (length) (depth to top)
  - (6) pump 1/2 (HP) 10 (yield gpm) 2201 (type power)
  - (7) electric log No (yes or no)
  - (8) how well bottom plugged Cap (organization running log)

DRILLERS REMARKS:


DEPT. OF NATURAL RESOURCES  
 BUREAU OF LAND & WATER RESOURCES

APR - 4 1983

RECEIVED

If well telescopes please sketch and show depths.

GROUND LEVEL

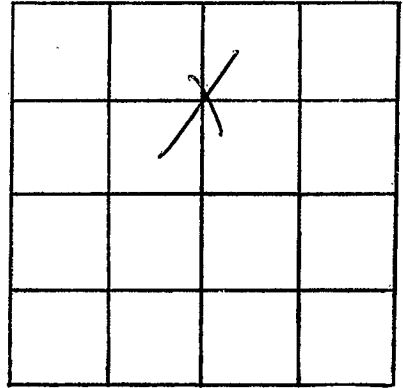

SECTION 11

Please indicate well location X.

ADDITIONAL INFORMATION

If more than one screen, show locations of each on sketch.