

MISSISSIPPI DEPARTMENT OF NATURAL RESOURCES

Bureau of Land and Water Resources

Southport Mall

P.O. Box 10631

Jackson, Mississippi 39209

WATER WELL DRILLERS LOG

Date
H 2080

5-17-83
date well completed

HICKS WELL CO.
No. 1 Box 157
Senatobia, Miss 38668

Tate
county well located

LANDOWNER: Noel Sutton
Pt. 2
Caldwater, Miss. 38618
(mailing address)

description of formations encountered	depth	
	from	to
Red Clay	0	10
Red Sand	10	50

WELL LOCATION:
sec. 6 T. 5 N. R. 6 E.
1 miles W of Boguilla
(distance) (direction) (nearest town)

White Sand	50	170
------------	----	-----

WELL PURPOSE: Home
(home, irrigation, municipal, industrial)

WELL COMPLETION DATA:

(1) diameter (inches) 4

(2) total depth (feet) 170

(3) static water level (feet) 100 below above top of ground.

(4) casing PVC, 170, (material) (depth)
4" (size) if telescope see back.

(5) screen 10', 160 (length) (depth to top)
0.13 PVC (size) (material)

(6) pump 1/2 HP, 10 (yield gpm)
220V (type power)

(7) electric log No (yes or no)
(organization running log)

(8) how well bottom plugged Cap

DEPT. OF NATURAL RESOURCES
BUREAU OF LAND & WATER RESOURCES


MAY 25 1983

RECEIVED

DRILLERS REMARKS:

If well telescopes please sketch and show depths.

GROUND LEVEL

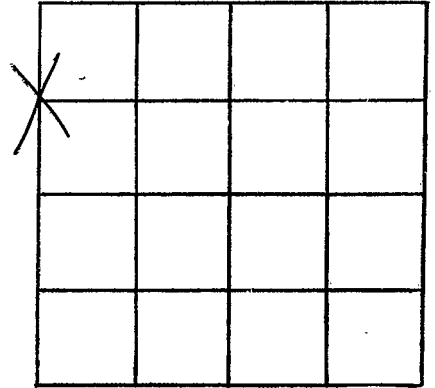

SECTION 6

Please indicate well location X.

ADDITIONAL INFORMATION

If more than one screen,
show locations of each on sketch.