

MISSISSIPPI DEPARTMENT OF NATURAL RESOURCES

Bureau of Land and Water Resources

Southport Mall

P.O. Box 10631

Jackson, Mississippi 39209

WATER WELL DRILLERS LOG

HICKS WELL CO.

P.O. Box 157

Senatobia, MS 38668

Date
 H 2081

9-6 1983
 date well completed

Tate
 county well located

LANDOWNER: Pinus Leary
Rt. 3
Senatobia, Ms. 38668
 (mailing address)

| description of formations encountered | from | to |
|---------------------------------------|----------|----|
| | Red Clay | 0 |
| Red Sand | 10 | 40 |

WELL LOCATION:
 sec. 20 T 5 N R 6 E
2 miles SE of Senatobia
 (distance) (direction) (nearest town)

| | | |
|------------|----|-----|
| White Sand | 40 | 140 |
|------------|----|-----|

WELL PURPOSE: Home
 (home, irrigation, municipal, industrial)

WELL COMPLETION DATA:
 (1) diameter (inches) 4
 (2) total depth (feet) 140
 (3) static water level (feet) 60 below top of ground.
 (4) casing PVC, 140
 (material) (depth)
4"
 (size) If telescope see back.
 (5) screen 10', 130
 (length) (depth to top)
813, PVC
 (size) (material)
 (6) pump 1/2, 10
 (HP) (yield gpm)
220V
 (type power)
 (7) electric log No
 (yes or no)
 (organization running log)
 (8) how well bottom plugged Cap

DEPT. OF NATURAL RESOURCES
 BUREAU OF LAND & WATER RESOURCES


SEP 22 1983

RECEIVED

DRILLERS REMARKS:

If well telescopes please sketch and show depths.

GROUND LEVEL

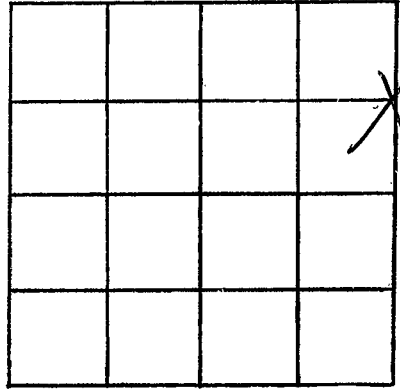

SECTION 20

Please indicate well location X.

ADDITIONAL INFORMATION

If more than one screen, show locations of each on sketch.