

MISSISSIPPI DEPARTMENT OF NATURAL RESOURCES

Bureau of Land and Water Resources

Southport Mall

P.O. Box 10631

Jackson, Mississippi 39209

WATER WELL-DRILLERS LOG

HICKS WELL CO.

Rt. 1, Box 157

Senatobia, MS 38668

Date
H
2082

11-2 1983
date well completed

Tate
county well located

LANDOWNER: Thomas Robertson
Rt. 3

description of formations encountered from to

Senatobia, Miss.
(mailing address) 38668

Red Clay 0 20

WELL LOCATION:
sec. 20 T 5 N R 6 E
2 miles NW of Senatobia
(distance) (direction) (nearest town)

Red Sand 20 50

White Sand & Clay 50 110

White Sand 110 130

WELL PURPOSE: Home
(home, irrigation, municipal, industrial)

WELL COMPLETION DATA:

- (1) diameter (inches) 4
- (2) total depth (feet) 130
- (3) static water level (feet) 60 below top of ground.
- (4) casing PVC, 130 (depth)
4" (size) if telescope see back.
- (5) screen 10' (length), 120' (depth to top)
1/2" (size), PVC (material)
- (6) pump 1/2 (HP), 10 (yield gpm)
220V (type power)
- (7) electric log Yes (yes or no)

(organization running log)

(8) how well bottom plugged Cap

DRILLERS REMARKS:


DEPT. OF NATURAL RESOURCES
BUREAU OF LAND & WATER RESOURCES

NOV 14 1983

RECEIVED

If well telescopes please sketch and show depths.

GROUND LEVEL

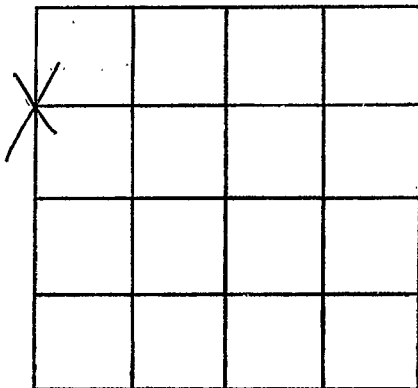

SECTION 20

Please indicate well location X.

ADDITIONAL INFORMATION

If more than one screen,
show locations of each on sketch.