

MISSISSIPPI DEPARTMENT OF NATURAL RESOURCES

Bureau of Land and Water Resources

Southport Mall

P.O. Box 10631

Jackson, Mississippi 39209

WATER WELL DRILLERS LOG

HICKS WELL CO.

Rt. 1, Box 157

Senatobia, MS 38668

Date  
H 2084

5/7 1984  
date well completed

Tato  
county well located

LANDOWNER: Clifton Dandridge

Rt. 2 Box 224

Colwater, Ms. 38618

(mailing address)

description of formations encountered

from

to

Red Clay

0

30

White sand

30

105

WELL LOCATION:

sec. 17 T 5 N R 6 E

2 miles S of Boaquille  
(distance) (direction) (nearest town)

WELL PURPOSE:

Home  
(home, irrigation, municipal, industrial)

WELL COMPLETION DATA:

(1) diameter (inches) 4

(2) total depth (feet) 105'

(3) static water level (feet) 60 <sup>below</sup> <sub>above</sub> top of ground.

(4) casing PVC, 105'  
(material) (depth)

4"  
(size) if telescope see back.

(5) screen 10', 95'  
(length) (depth to top)

1010, PVC  
(size) (material)

(6) pump 1/2 10  
(HP) (yield gpm)

220V  
(type power)

(7) electric log Y/N  
(yes or no)

(organization running log)

(8) how well bottom plugged Cap


DRILLERS REMARKS:

DEPT. OF NATURAL RESOURCES  
BUREAU OF LAND & WATER RESOURCES

RECEIVED  
MAY 23 1984

If well telescopes please sketch and show depths.

GROUND LEVEL

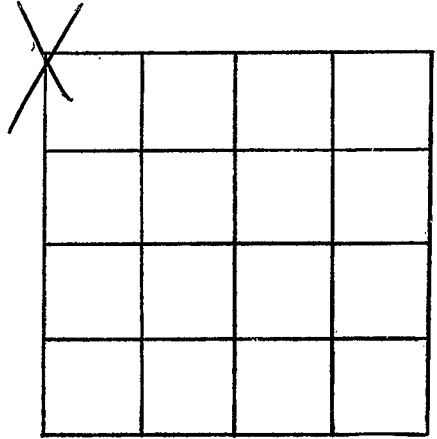

SECTION 17

Please indicate well location X.

ADDITIONAL INFORMATION

If more than one screen,  
show locations of each on sketch.