

MISSISSIPPI DEPARTMENT OF NATURAL RESOURCES

Bureau of Land and Water Resources

Southport Mall

P.O. Box 10631

Jackson, Mississippi 39209

WATER WELL DRILLERS LOG

TATE
H 2085

2/11 1984
date well completed

HICKS WELL CO.
firm name
Senatobia MS 38668

Tate
county well located

LANDOWNER: Sharon Newman
Pt. 3
Senatobia, Ms. 38668
(mailing address)

description of formations encountered	from to	
Red Clay	0	10
Red sand	10	50
White sand	50	135

WELL LOCATION:
sec. 20 T 5 N R 6 E
2 miles NW of Lodi, La.
(distance) (direction) (nearest town)

WELL PURPOSE: Home
(home, irrigation, municipal, industrial)


- WELL COMPLETION DATA:
- (1) diameter (inches) 4
 - (2) total depth (feet) 135
 - (3) static water level (feet) 80 below top of ground.
 - (4) casing PVC, 135' (material), (depth)
4" (size) if telescope see back.
 - (5) screen 10' (length), 125' (depth to top)
0.10 (size), PVC (material)
 - (6) pump 1/2 (HP), 10 (yield gpm)
220V (type power)
 - (7) electric log No (yes or no)
(organization running log)
 - (8) how well bottom plugged Cap

DRILLERS REMARKS:

DEPT. OF NATURAL RESOURCES
BUREAU OF LAND & WATER RESOURCES
JUL 10 1984
RECEIVED

If well telescopes please sketch and show depths.

GROUND LEVEL

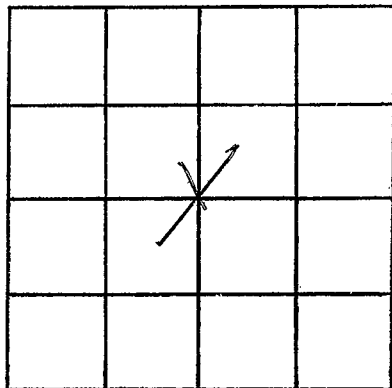

SECTION 20

Please indicate well location X.

ADDITIONAL INFORMATION

If more than one screen,
show locations of each on sketch.