

MISSISSIPPI DEPARTMENT OF NATURAL RESOURCES

Bureau of Land and Water Resources

Southport Mall

P.O. Box 10631

Jackson, Mississippi 39209

WATER WELL DRILLERS LOG

TATE  
H 2086

6/8 1984  
date well completed

NICKS WELL CO.  
firm name: NICKS  
Canton, MS 39020

Tate  
county well located

LANDOWNER: Tim Whitehead  
Pt. 3  
Senatobia, Ms. 38668  
(mailing address)

description of formations encountered	from	to
Red Clay	0	10
Red Sand	10	50
White sand	50	85
Black Clay	85	195
White Sand	195	235

WELL LOCATION:  
sec. 28 T. 5 N. R. 6 E  
1 miles N of Jackson  
(distance) (direction) (nearest town)

WELL PURPOSE: HOME  
(home, irrigation, municipal, industrial)


- WELL COMPLETION DATA:
- (1) diameter (inches) 4
  - (2) total depth (feet) 235'
  - (3) static water level (feet) 60 below above top of ground.
  - (4) casing PVC, 235'  
(material) (depth)  
4" (size) if telescope see back.
  - (5) screen 10', 225'  
(length) (depth to top)  
1010 PVC  
(size) (material)
  - (6) pump 1 18  
(HP) (yield gpm)  
220V  
(type power)
  - (7) electric log No  
(yes or no)
  - (organization running log)
  - (8) how well bottom plugged Cap

DRILLERS REMARKS:

DEPT. OF NATURAL RESOURCES  
BUREAU OF LAND & WATER RESOURCES  
JUL 10 1984  
RECEIVED

If well telescopes please sketch and show depths.

GROUND LEVEL

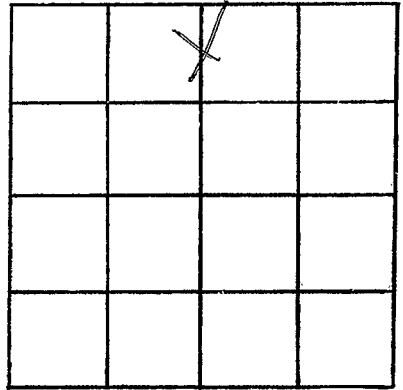

SECTION 28

Please indicate well location X.

ADDITIONAL INFORMATION

If more than one screen,  
show locations of each on sketch.