

MISSISSIPPI DEPARTMENT OF NATURAL RESOURCES

Bureau of Land and Water Resources

Southport Mall

P.O. Box 10631

Jackson, Mississippi 39209

WATER WELL DRILLERS LOG

Date
H 2081

7-10 19 84
 date well completed

HICKS WELL CO.
 firm name
 Senatobia MS 38668

Tate
 county well located

LANDOWNER: Mike English
Rt. 3
Senatobia, Mo. 38668
 (mailing address)

description of formations encountered	from	to
<u>Red Clay</u>	<u>0</u>	<u>10</u>
<u>Red Sand</u>	<u>10</u>	<u>65</u>
<u>white sand</u>	<u>65</u>	<u>140</u>

WELL LOCATION:
 sec. 28 T 5 N R 6 E
1 miles N of Loofahome
 (distance) (direction) (nearest town)

WELL PURPOSE: Home
 (home, irrigation, municipal, industrial)

WELL COMPLETION DATA:


- (1) diameter (inches) 4
- (2) total depth (feet) 140
- (3) static water level (feet) 80 below top of ground.
- (4) casing PVC 140
 (material) (depth)
4" if telescope see back.
 (size)
- (5) screen 10' 130'
 (length) (depth to top)
0 10 PVC
 (size) (material)
- (6) pump 1/2 10
 (HP) (yield gpm)
220V
 (type power)
- (7) electric log No
 (yes or no)
 (organization running log)
- (8) how well bottom plugged Cap

DRILLERS REMARKS:

DEPT. OF NATURAL RESOURCES
 BUREAU OF LAND & WATER RESOURCES
 SEP 24 1984
 RECEIVED

If well telescopes please sketch and show depths.

GROUND LEVEL

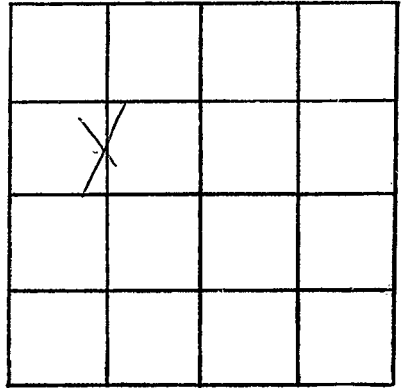

SECTION 28

Please indicate well location X.

ADDITIONAL INFORMATION

If more than one screen,
show locations of each on sketch.