

MISSISSIPPI DEPARTMENT OF NATURAL RESOURCES

Bureau of Land and Water Resources

Southport Mall

P.O. Box 10631

Jackson, Mississippi 39209

WATER WELL DRILLERS LOG

HICKS WELL CO.

Rt. 1, Box 157

Senatobia, MS 38668

Date  
H 2088

7-12 19 84  
date well completed

Tate  
county well located

LANDOWNER: Mike Benton  
Rt. 1  
Senatobia, Ms. 38668  
(mailing address)

description of formations encountered	from	to
Red Clay	0	10
Red Sand	10	50
White Sand	50	140

WELL LOCATION:  
sec. 13 T 5 N R 6 E  
1 1/2 miles N of Bau  
(distance) (direction) (nearest town)

WELL PURPOSE: Home  
(home, irrigation, municipal, industrial)


- WELL COMPLETION DATA:
- (1) diameter (inches) 4
  - (2) total depth (feet) 140
  - (3) static water level (feet) 80 below top of ground.
  - (4) casing PVC, 140 (depth)  
4" (size) if telescope see back.
  - (5) screen 10 (length), 130' (depth to top)  
1.010 (size), PVC (material)
  - (6) pump 1/2 (HP), 10 (yield gpm)  
220V (type power)
  - (7) electric log No (yes or no)  
(organization running log)
  - (8) how well bottom plugged Cap

DRILLERS REMARKS:

DEPT. OF NATURAL RESOURCES  
BUREAU OF LAND & WATER RESOURCES  
RECEIVED  
SEP 24 1984

If well telescopes please sketch and show depths.

GROUND LEVEL

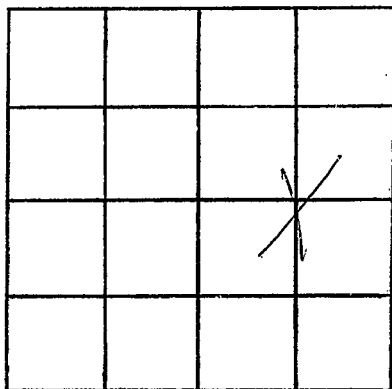

SECTION 13

Please indicate well location X.

ADDITIONAL INFORMATION

If more than one screen,  
show locations of each on sketch.