

MISSISSIPPI DEPARTMENT OF NATURAL RESOURCES

Bureau of Land and Water Resources

Southport Mall

P.O. Box 10631

Jackson, Mississippi 39209

WATER WELL DRILLERS LOG

Date
H 2089

HICKS WELL CO.

Tate

8-1 19 84 date well completed

firm name

county well located


LANDOWNER: <u>Margaret Dandridge</u>	description of formations encountered	from	to
<u>Pt. 2</u>			
<u>Caldwater, Ms. 38618</u> (mailing address)	<u>Red Clay</u>	<u>0</u>	<u>10</u>
	<u>Red Sand</u>	<u>10</u>	<u>30</u>
WELL LOCATION: sec. <u>16</u> T <u>5</u> N R <u>6</u> E _____ miles _____ of <u>Fredonia</u> (distance) (direction) (nearest town)	<u>white clay</u>	<u>30</u>	<u>60</u>
	<u>white sand</u>	<u>60</u>	<u>100</u>
WELL PURPOSE: <u>Home</u> (home, irrigation, municipal, industrial)			
WELL COMPLETION DATA:			
(1) diameter (inches) <u>4</u>			
(2) total depth (feet) <u>150</u>			
(3) static water level (feet) <u>40</u> ^{below} / _{above} top of ground.			
(4) casing <u>PVC</u> , <u>180</u> , (material) (depth) <u>4"</u> If telescope see back. (size)			
(5) screen <u>10'</u> , <u>90'</u> (length) (depth to top) <u>.010</u> , <u>PVC</u> (size) (material)			
(6) pump <u>1/2</u> , <u>10</u> (HP) (yield gpm) <u>220V</u> (type power)			
(7) electric log <u>No</u> (yes or no) _____ (organization running log)			
(8) how well bottom plugged <u>Cap</u>			
DRILLERS REMARKS:			

DEPT. OF NATURAL RESOURCES
BUREAU OF LAND & WATER RESOURCES

SEP 24 1984
RECEIVED

If well telescopes please sketch and show depths.

GROUND LEVEL

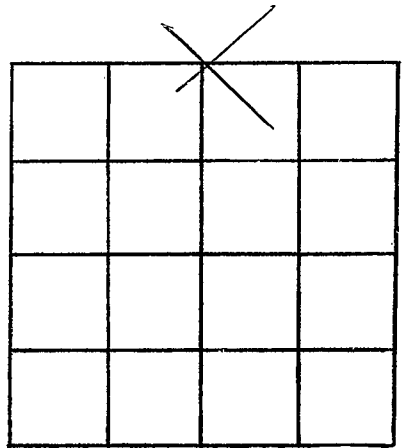

SECTION 16

Please indicate well location X.

ADDITIONAL INFORMATION

If more than one screen, show locations of each on sketch.