

MISSISSIPPI DEPARTMENT OF NATURAL RESOURCES

Bureau of Land and Water Resources

Southport Mall

P.O. Box 10631

Jackson, Mississippi 39209

WATER WELL DRILLERS LOG

Date
8-7
1984

HICKS WELL CO.
 firm name

late
 county well located

8-7 1984
 date well completed

LANDOWNER: Esker Copeland

description of formations encountered

from

to

Rt. 2

Colquhoun, Ms. 38618

(mailing address)

Red Clay

0 10

Red Sand

10 30

WELL LOCATION:

sec. 17 T. 5 N. R. 6 E. W. 3
3 miles of Freedom
 (distance) (direction) (nearest town)

white Clay

30 60

white Sand

60 110

WELL PURPOSE: Home
 (home, irrigation, municipal, industrial)

WELL COMPLETION DATA:

- (1) diameter (inches) 4
- (2) total depth (feet) 110
- (3) static water level (feet) 60 ^{below}/_{above} top of ground.
- (4) casing PVC 110
 (material) (depth)
4"
 (size) If telescope see back.
- (5) screen 10' 150
 (length) (depth to top)
10/16 PVC
 (size) (material)
- (6) pump 1/2 10
 (HP) (yield gpm)
220V
 (type power)
- (7) electric log No
 (yes or no)

(organization running log)

(8) how well bottom plugged Cap

DRILLERS REMARKS:


DEPT. OF NATURAL RESOURCES
 BUREAU OF LAND & WATER RESOURCES

SEP 24 1984

RECEIVED

If well telescopes please sketch and show depths.

GROUND LEVEL

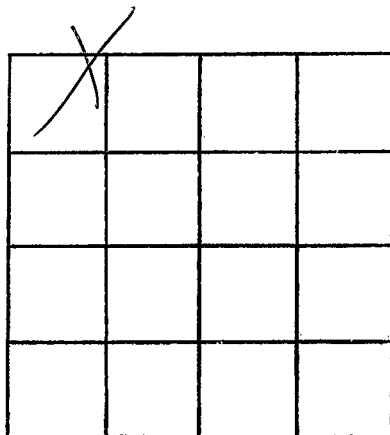

SECTION 17

Please indicate well location X.

ADDITIONAL INFORMATION

If more than one screen, show locations of each on sketch.