

MISSISSIPPI DEPARTMENT OF NATURAL RESOURCES

Bureau of Land and Water Resources

Southport Mall

P.O. Box 10631

Jackson, Mississippi 39209

WATER WELL DRILLERS LOG

Date
8-29
1984

date well completed 8-29 1984

firm name WATER WELL CO.

county well located Tate

LANDOWNER: <u>J. T. Hensley</u> <u>Pct. 1</u>	description of formations encountered	from	to
<u>Senatobia, Mo. 38668</u> (mailing address)	<u>Red Clay</u>	<u>0</u>	<u>10</u>
WELL LOCATION: sec. <u>24</u> <u>T 5</u> <u>N</u> R. <u>6</u> <u>E</u> <u>1/2</u> miles <u>N</u> of <u>Barr</u> (distance) (direction) (nearest town)	<u>Red Sand</u>	<u>18</u>	<u>80</u>
WELL PURPOSE: <u>Home</u> (home, irrigation, municipal, industrial)	<u>White Sand</u>	<u>80</u>	<u>174</u>
WELL COMPLETION DATA:			
(1) diameter (inches) <u>4</u>			
(2) total depth (feet) <u>174</u>			
(3) static water level (feet) <u>180</u> <u>below</u> above top of ground.			
(4) casing <u>PVC</u> , <u>174</u> , (material) (depth) <u>4"</u> (size) If telescope see back.			
(5) screen <u>10'</u> , <u>164'</u> (length) (depth to top) <u>10/10</u> , <u>PVC</u> (size) (material)			
(6) pump <u>3/4</u> , <u>10</u> (HP) (yield gpm) <u>220V</u> (type power)			
(7) electric log <u>No</u> (yes or no)			
(organization running log)			
(8) how well bottom plugged <u>Cop</u>			
DRILLERS REMARKS:			


DEPT. OF NATURAL RESOURCES
 BUREAU OF LAND & WATER RESOURCES

SEP 24 1984

RECEIVED

If well telescopes please sketch and show depths.

GROUND LEVEL

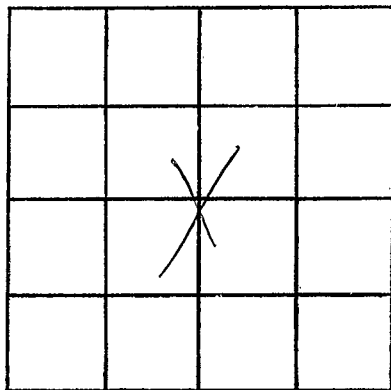

SECTION 24

Please indicate well location X.

ADDITIONAL INFORMATION

If more than one screen, show locations of each on sketch.