

MISSISSIPPI DEPARTMENT OF NATURAL RESOURCES

Bureau of Land and Water Resources

Southport Mall

P.O. Box 10631

Jackson, Mississippi 39209

WATER WELL DRILLERS LOG

HICKS WELL CO.

Rt. 1, Box 157

Senatobia, MS 38668

Date _____

9-28 1984
 date well completed

Tate
 county well located

LANDOWNER: Jerry Roberson
Paul Ray Comm.
Senatobia, Ms. 38668
 (mailing address)

description of formations encountered	from	to
Red Clay	0	10
Red Sand	10	80
White Sand	80	140

WELL LOCATION:
 sec. 13 T 5 N R. 6 E
1 1/2 miles N of Bay
 (distance) (direction) (nearest town)

WELL PURPOSE: Home
 (home, irrigation, municipal, industrial)

WELL COMPLETION DATA:

(1) diameter (inches) 4

(2) total depth (feet) 140

(3) static water level (feet) 80 ^{below} above top of ground.

(4) casing PVC 140
 (material) (depth)
4" if telescope see back.
 (size)

(5) screen 10' 130'
 (length) (depth to top)
10 PVC
 (size) (material)

(6) pump 1/2 10
 (HP) (yield gpm)
220V
 (type power)

(7) electric log No
 (yes or no)

 (organization running log)

(8) how well bottom plugged cap

DRILLERS REMARKS: _____


DEPT. OF NATURAL RESOURCES
 BUREAU OF LAND & WATER RESOURCES

NOV 28 1984

RECEIVED

If well telescopes please sketch and show depths.

GROUND LEVEL

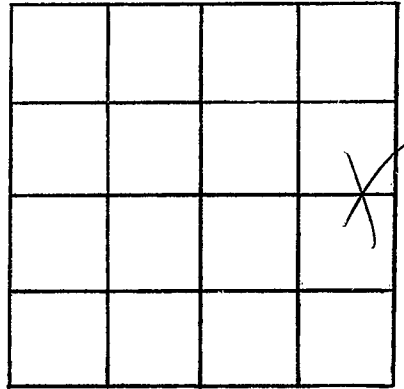

SECTION ~~12~~ 13

Please indicate well location X.

ADDITIONAL INFORMATION

If more than one screen, show locations of each on sketch.