

MISSISSIPPI DEPARTMENT OF NATURAL RESOURCES

Bureau of Land and Water Resources

Southport Mall

P.O. Box 10631

Jackson, Mississippi 39209

WATER WELL DRILLERS LOG

MICKS WELL CO.

Rt. 1, Box 157

Senatobia, MS 38668

Tate
H 2093
5-29-85

5-29 1985
date well completed

TATE
county well located


LANDOWNER: <u>Wayne Crockett</u> <u>RT #1</u>	description of formations encountered	from	to
<u>Senatobia ms 38668</u> (mailing address)	<u>Red clay</u>	<u>0</u>	<u>10</u>
	<u>Red sand</u>	<u>10</u>	<u>30</u>
WELL LOCATION:	<u>White sand & clay</u>	<u>30</u>	<u>60</u>
sec. <u>35</u> T. <u>5</u> N. R. <u>6</u> E.	<u>White sand</u>	<u>60</u>	<u>125</u>
<u>4</u> miles <u>SW</u> of <u>Barr</u>	<u>Black clay</u>	<u>125</u>	<u>140</u>
(distance) (direction) (nearest town)			
WELL PURPOSE: <u>home</u> (home, irrigation, municipal, industrial)			
WELL COMPLETION DATA:			
(1) diameter (inches) <u>4"</u>			
(2) total depth (feet) <u>140'</u>			
(3) static water level (feet) <u>100'</u> <u>below</u> top of ground.			
(4) casing <u>PVC</u> , <u>110</u> (material) (depth) <u>4"</u> (size) if telescope see back.			
(5) screen <u>15'</u> , <u>130'</u> (length) (depth to top)			
.010, <u>PVC</u> (size) (material)			
(6) pump <u>1 hp</u> , <u>18</u> (HP) (yield gpm) <u>220 Electric</u> (type power)			
(7) electric log <u>NO</u> (yes or no) (organization running log)			
(8) how well bottom plugged <u>Cap</u>			
DRILLERS REMARKS: <u>It's got 15 ft of deadman on it as well as 15 ft of screen</u>			

RECEIVED
JUL 1 - 1985

Department of Natural Resources
Bureau of Land & Water Resources

If well telescopes please sketch and show depths.

GROUND LEVEL

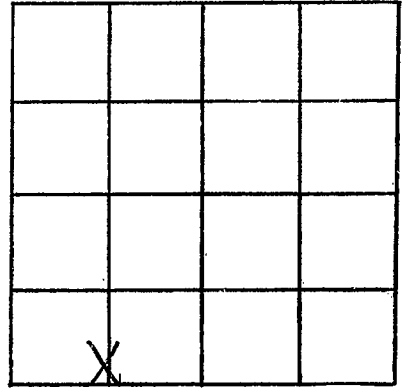

SECTION 35

Please indicate well location X.

ADDITIONAL INFORMATION

If more than one screen,
show locations of each on sketch.