

MISSISSIPPI DEPARTMENT OF NATURAL RESOURCES

Bureau of Land and Water Resources

Southport Mall

P.O. Box 10631

Jackson, Mississippi 39209

WATER WELL DRILLERS LOG

TATE
H
2097

1-10 1986 date well completed Niche Well Co firm name Tate county well located

LANDOWNER: <u>Allie Dondidge</u> <u>Rt # 1</u> <u>Senatobia MS 38668</u> (mailing address)	description of formations encountered	from	to
	Red clay	0	10
	Red sand	10	50

WELL LOCATION:
 sec. 8 T. 5 N. R. 6 E
2 miles S of Senatobia
 (distance) (direction) (nearest town)

	White sand	50	140
--	------------	----	-----

WELL PURPOSE: Home
 (home, irrigation, municipal, industrial)

WELL COMPLETION DATA:

- (1) diameter (inches) 4"
- (2) total depth (feet) 140'
- (3) static water level (feet) 60' below above top of ground.
- (4) casing PVC (130' material) (depth)
4" if telescope see back. (size)
- (5) screen 10' (length) 130' (depth to top)
Ø 3 4" (size) PVC (material)
- (6) pump 1/2 (HP) 10 (yield gpm)
220V (type power)
- (7) electric log NO (yes or no)
 (organization running log)
- (8) how well bottom plugged Cap


MISSISSIPPI DEPARTMENT OF NATURAL RESOURCES
 BUREAU OF LAND & WATER RESOURCES
 MAY 5 1986

DRILLERS REMARKS:

Department of Natural Resources
 Bureau of Land & Water Resources

If well telescopes please sketch and show depths.

GROUND LEVEL

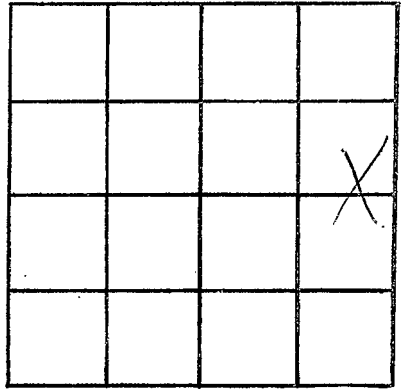

SECTION 8

Please indicate well location X.

ADDITIONAL INFORMATION

If more than one screen,
show locations of each on sketch.