

TATE
H2098


MISSISSIPPI DEPARTMENT OF NATURAL RESOURCES
 Bureau of Land and Water Resources
 Southport Mall
 P.O. Box 10631
 Jackson, Mississippi 39209
WATER WELL DRILLERS LOG

date well completed 1-11-1986 HICKS WELL COMPANY Ita
 RT. 1 Box 107 county well located

LANDOWNER: <u>Cornel Rinchen</u>	description of formations encountered	from	to
RT # <u>2</u>			
<u>Caldwate MS 38618</u> (mailing address)	<u>Red clay</u>	<u>0</u>	<u>10</u>
WELL LOCATION:	<u>Red sand</u>	<u>10</u>	<u>50</u>
sec. <u>8</u> T. <u>5</u> N. R. <u>6</u> E	<u>white sand</u>	<u>50</u>	<u>140</u>
<u>2</u> miles <u>SE</u> of <u>Passville</u>			
(distance) (direction) (nearest town)			
WELL PURPOSE: <u>Drain</u>			
(home, irrigation, municipal, industrial)			
WELL COMPLETION DATA:			
(1) diameter (inches) <u>4"</u>			
(2) total depth (feet) <u>140'</u>			
(3) static water level (feet) <u>65'</u> <u>below</u> above top of ground.			
(4) casing <u>PVC</u> , <u>130'</u> (material) (depth)			
<u>4"</u> if telescope see back. (size)			
(5) screen <u>10'</u> , <u>130'</u> (length) (depth to top)			
<u>013</u> , <u>PVC</u> (size) (material)			
(6) pump <u>1/2</u> , <u>10</u> (HP) (yield gpm)			
<u>220 V</u> (type power)			
(7) electric log <u>NO</u> (yes or no)			
<u> </u> (organization running log)			
(8) how well bottom plugged <u>Cap</u>			
DRILLERS REMARKS:			

If well telescopes please sketch and show depths.

GROUND LEVEL

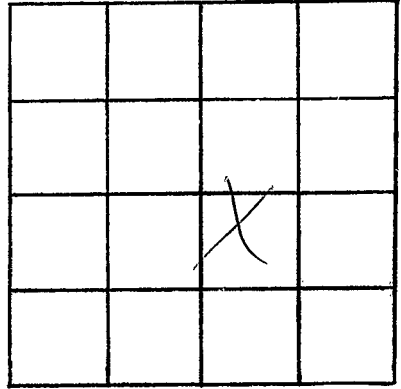

SECTION 8

Please indicate well location X.

ADDITIONAL INFORMATION

If more than one screen,
show locations of each on sketch.