

MISSISSIPPI DEPARTMENT OF NATURAL RESOURCES
Bureau of Land and Water Resources
 Southport Mall
 P.O. Box 10631
 Jackson, Mississippi 39209
WATER WELL DRILLERS LOG

DATE
Hand

10-18-90 date well completed LIDE WELL & SUPPLY CO. INC. firm name TATE county well located

LANDOWNER: EDWIN LOWRY
 3535 Brights RD.
 HERMINDO, MS.
 (mailing address)


WELL LOCATION:
 sec. 6 T 5 N R 6 E
 5 miles WEST of Coldwater
 (distance) (direction) (nearest town)

WELL PURPOSE: HOME
 (home, irrigation, municipal, industrial)

WELL COMPLETION DATA:

(1) diameter (inches) 4
 (2) total depth (feet) 220
 (3) static water level (feet) _____ below/above top of ground.
 (4) casing PVC, 210 (material), (depth), 4 (size) if telescope see back.
 (5) screen 10, 210 (length), (depth to top), 4, PVC (size), (material)
 (6) pump 1 (HP), (yield gpm), (type power)
 (7) electric log (yes or no), (organization running log)
 (8) how well bottom plugged CAPPED

description of formations encountered	from	to
Top soil, GRAVEL + SAND	0	20
GRAVEL - CLAY	20	40
CLAY	40	60
CLAY	60	80
CLAY streaks of SAND	80	100
CLAY	100	120
CLAY	120	140
CLAY - Small Rock	140	160
CLAY - STREAK of SAND	160	180
CLAY	180	200
SAND	200	220

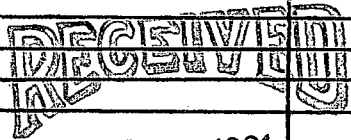


APR 16 1991

Dept. of Environmental Quality
 Bureau of Land & Water Resources

DRILLERS REMARKS:

If well telescopes please
sketch and show depths.

GROUND LEVEL

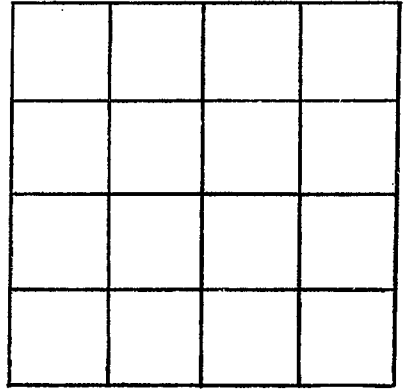

SECTION _____

Please indicate well location X.

ADDITIONAL INFORMATION

If more than one screen,
show locations of each on sketch.