

MISSISSIPPI DEPARTMENT OF ENVIRONMENTAL QUALITY

Office of Land and Water Resources

P. O. Box 10631
Jackson, MS 39289-0631

WATER WELL DRILLERS LOG

COUNTY WELL LOCATED <u>ITAC</u>	
WELL NUMBER <u>H 2189</u>	CODED
DATE WELL COMPLETED <u>10-3-95</u>	

PERMIT NUMBER	HICKS WELL CO.
NAME OF DRILLING FIRM	
<u>RT. 1 BOX 157</u>	
<u>SENATOBIA, MS 38668</u>	

NAME & MAILING ADDRESS OF LANDOWNER <u>BEN NEWMAN</u>			
<u>RT. 3 BOX 21</u>			
<u>SENATOBIA, MS.</u>			
WELL LOCATION:	SEC	TOWNSHIP	RANGE
	<u>30</u>	<u>5</u>	<u>N 6 W</u>
DISTANCE	DIRECTION	NEAREST TOWN	
<u>7</u> Miles	<u>E</u>	of <u>Senatobia</u>	
OTHER LANDMARK			
WELL PURPOSE: Home, Irrigation, Municipal, Industrial, Fish Pond, etc. <u>HOME</u>			

PUMP DATA		
PUMP TYPE (Circle One): <u>Submersible</u> , Turbine, Jet, Flowing Well, Other (Describe) _____		
POWER TYPE (Circle One): <u>Electric</u> , Tractor, Diesel, Gasoline, Butane, Other (Describe) _____ H/P <u>1/2</u>		
Pump Capacity (GPM) <u>10</u>	No. of Stages <u>9</u>	Setting Depth <u>80</u> FT.
PUMP TEST		
Well yielded _____ GPM with a drawdown of _____ ft. after _____ hours of pumping		

WELL DATA		
Well Depth <u>130'</u>	Casing Diameter (In.) <u>4"</u>	Casing Length (Ft.) <u>120'</u>
Type of Casing <u>PVC</u>	Hole Depth <u>130'</u>	Depth to Static Water Level <u>60'</u>

LOG DATA	
TYPE OF LOG RUN (Circle One): No Log Run, Electric, Gamma Ray, Density, Sonic, Neutron, Other (Describe) _____	
Name of Organization Running Log	

TYPE OF COMPLETION: (Circle One or More): <u>Gravel Packed</u> , Underreamed, Telescoped, Natural Development, Open Hole, Other (Describe) _____		
---	--	--

WELL GROUTED TO A DEPTH OF <u>10'</u> FEET Type Grout (circle one): Cement, Bentonite, or Mix
--

GEOLOGIC DATA (Office Use Only)			
Surface Elev.	Geologic Unit	Unit Thickness	Depth to Top
Subs. SWL	Date	Analysis	Aquifer Test
Driller's Remarks			
Top of Lap Pipe or Reduction in Casing			
FEET		IF TELESCOPED OR MORE THAN ONE SCREEN: USE BACK PAGE	

SCREEN DATA		
Diameter - Inches <u>4"</u>	Length - Feet <u>10'</u>	Slot Size - Inches <u>013</u>
Screen Type <u>PVC</u>	Depth to Bottom - Feet <u>10'</u>	


DESCRIPTION OF FORMATIONS ENCOUNTERED	FROM	TO
<u>Red SAND</u>	<u>0</u>	<u>60</u>
<u>SAND & CLAY</u>	<u>60</u>	<u>100</u>
<u>White SAND</u>	<u>100</u>	<u>130</u>

FORMATIONS (Continued)	FROM	TO
RECEIVED		
JAN 16 1996		
Dept. of Environmental Quality Office of Land & Water Resources		

IF MORE SPACE IS NEEDED, USE BACK

If well telescopes please
sketch and show depths.

GROUND LEVEL

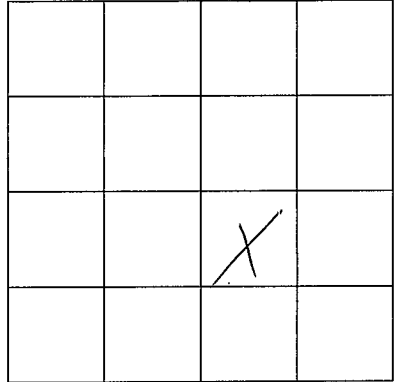

SECTION 30

Please indicate well location X.

ADDITIONAL INFORMATION

If more than one screen,
show location of each on sketch.