

MISSISSIPPI DEPARTMENT OF ENVIRONMENTAL
QUALITY

Office of Land and Water Resources

P. O. Box 10631
Jackson, MS 39289-0631
WATER WELL DRILLERS LOG

COUNTY WELL LOCATED
TATE

WELL NUMBER **A 2155** CODED

DATE WELL COMPLETED
2-16-98

PERMIT NUMBER
HICK WATER WELL CO.
NAME OF DRILLING TEAM

30242 HWY. 4 EAST
SENATOBIA, MS 38668

NAME & MAILING ADDRESS OF LANDOWNER
Golden Timber Co

P.O. Box 652

Senatobia, MS 38668

WELL LOCATION: SEC **24** TOWNSHIP **S** RANGE **6** **E**

DISTANCE **—** Miles DIRECTION **—** of NEAREST TOWN **BARR**

OTHER LANDMARK
Woodworking Shop

WELL PURPOSE: Home, Irrigation, Municipal, Industrial, Fish Pond, etc.

PUMP DATA

PUMP TYPE (Circle One):
Submersible Turbine, Jet, Flowing Well,
Other (Describe)

POWER TYPE (Circle One):
Electric Tractor, Diesel, Gasoline, Butane,
Other (Describe) **3/4** H/P

Pump Capacity (GPM) 12	No. of Stages	Setting Depth 200 FT.
----------------------------------	---------------	---------------------------------

PUMP TEST

Well yielded _____ GPM with
a drawdown of **no** ft.
after **Test** hours of pumping

WELL DATA

Well Depth 233	Casing Diameter (In.) 4	Casing Length (Ft.) 223
Type of Casing PVC	Hole Depth 233	Depth to Static Water Level 170

TYPE OF COMPLETION: (Circle One or More):
Gravel Packed Underreamed, Telescoped,
Natural Development, Open Hole, Other

WELL GROUTED TO A DEPTH OF **3** FEET
Type Grout (circle one): **Cement**, Bentonite, or Mix

LOG DATA

TYPE OF LOG RUN (Circle One): **No Log Run**,
Electric, Gamma Ray, Density, Sonic, Neutron,
Other (Describe)

Name of Organization Running Log

SCREEN DATA

Diameter - Inches 4	Length - Feet 10	Slot Size - Inches .013
Screen Type PVC slot	Depth to Bottom - Feet 223	

GEOLOGIC DATA (Office Use Only)

Surface Elev.	Geologic Unit	Unit Thickness	Depth to Top
Subs. SWL	Date	Analysis	Aquifer Test

Driller's Remarks

Top of Lap Pipe or Reduction in Casing


FEET IF TELESKOPED OR MORE THAN ONE SCREEN: USE BACK PAGE

DESCRIPTION OF FORMATIONS ENCOUNTERED	FROM	TO	FORMATIONS (Continued)	FROM	TO
White Clay	0	10			
Red Sand	10	110	03-03-98A10:07 RCVD		
White Sand + Clay	110	160			
White sand	160	233			

IF MORE SPACE IS NEEDED, USE BACK

If well telescopes please
sketch and show depths.

GROUND LEVEL

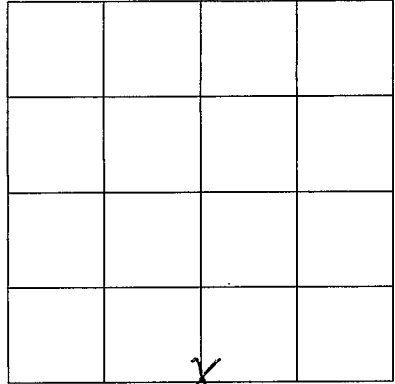

SECTION

24

Please indicate well location X.

ADDITIONAL INFORMATION

If more than one screen,
show location of each on sketch.