

**MISSISSIPPI DEPARTMENT OF ENVIRONMENTAL QUALITY**

Office of Land and Water Resources

COUNTY WELL LOCATED <b>TATE</b>	
WELL NUMBER <b>H 2162</b>	CODED
DATE WELL COMPLETED <b>7-8-98</b>	

PERMIT NUMBER <b>30242 HWY. 4 EAST</b>	
NAME OF PATENT OR FIRM <b>SENATOBIA, MS 38668</b>	

P. O. Box 10631  
Jackson, MS 39289-0631  
**WATER WELL DRILLERS LOG**

NAME & MAILING ADDRESS OF LANDOWNER <b>W.D. Fitch</b> <b>P.O. Box 41</b> <b>Senatobia, MS 38668</b>			
WELL LOCATION: SEC	TOWNSHIP	RANGE	
<b>30</b>	<b>50</b>	<b>6<sup>W</sup></b>	
DISTANCE	DIRECTION	NEAREST TOWN	
<b>2</b> Miles	<b>E</b>	<b>of Newtown</b>	
OTHER LANDMARK <b>280 Poplar Dr, Senatobia Lakes</b>			
WELL PURPOSE: <input checked="" type="checkbox"/> Home Irrigation, <input type="checkbox"/> Municipal, <input type="checkbox"/> Industrial, <input type="checkbox"/> Fish Pond, etc.			

<b>PUMP DATA</b>		
PUMP TYPE (Circle One): <input checked="" type="radio"/> Submersible <input type="radio"/> Turbine, <input type="radio"/> Jet <input type="radio"/> Flowing Well, Other (Describe) _____		
POWER TYPE (Circle One): <input checked="" type="radio"/> Electric, <input type="radio"/> Tractor, <input type="radio"/> Diesel, <input type="radio"/> Gasoline, <input type="radio"/> Butane, Other (Describe) _____ H/P <b>1/2</b>		
Pump Capacity (GPM) <b>10</b>	No. of Stages	Setting Depth <b>100</b> FT.
PUMP TEST		
Well yielded _____ GPM with		
a drawdown of <b>no</b> ft.		
after _____ hours of pumping		

<b>WELL DATA</b>		
Well Depth <b>120</b>	Casing Diameter (In.) <b>4</b>	Casing Length (Ft.) <b>110</b>
Type of Casing <b>PVC</b>	Hole Depth <b>120</b>	Depth to Static Water Level <b>80</b>
TYPE OF COMPLETION: (Circle One or More): <input checked="" type="checkbox"/> Gravel Packed <input type="checkbox"/> Underreamed, <input type="checkbox"/> Telescoped, <input type="checkbox"/> Natural Development, <input type="checkbox"/> Open Hole, <input type="checkbox"/> Other (Describe) _____		
WELL GROUTED TO A DEPTH OF <b>3</b> FEET Type Grout (circle one): <input checked="" type="radio"/> Cement, <input type="radio"/> Bentonite, or <input type="radio"/> Mix		

<b>LOG DATA</b>	
TYPE OF LOG RUN (Circle One): <input checked="" type="radio"/> No Log Run, <input type="radio"/> Electric, <input type="radio"/> Gamma Ray, <input type="radio"/> Density, <input type="radio"/> Sonic, <input type="radio"/> Neutron, Other (Describe) _____	
Name of Organization Running Log	

<b>SCREEN DATA</b>		
Diameter - Inches <b>4</b>	Length - Feet <b>10'</b>	Slot Size - Inches <b>.013</b>
Screen Type <b>PVC slot</b>	Depth to Bottom - Feet <b>110</b>	


<b>GEOLOGIC DATA (Office Use Only)</b>			
Surface Elev.	Geologic Unit	Unit Thickness	Depth to Top
Subs. SWL	Date	Analysis	Aquifer Test
Driller's Remarks <b>08-24-98 AG9:43 RCVD</b>			
Top of Lap Pipe or Reduction in Casing <b>FEET</b> IF TELESCOPED OR MORE THAN ONE SCREEN: USE BACK PAGE			

DESCRIPTION OF FORMATIONS ENCOUNTERED	FROM	TO	FORMATIONS (Continued)	FROM	TO
<b>Red + white Clay</b>	<b>0</b>	<b>10</b>			
<b>White Clay + fine sand</b>	<b>10</b>	<b>40</b>			
<b>White Clay + Sand</b>	<b>40</b>	<b>60</b>			
<b>White Sand + clay</b>	<b>60</b>	<b>80</b>			
<b>White Sand</b>	<b>80</b>	<b>120</b>			

IF MORE SPACE IS NEEDED, USE BACK

If well telescopes please  
sketch and show depths.

GROUND LEVEL

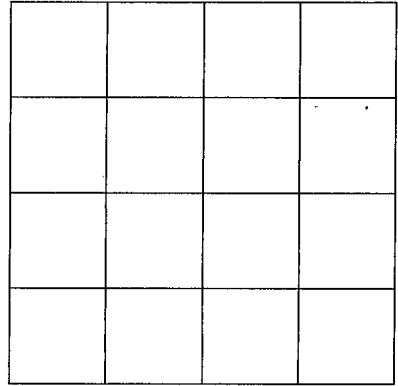

SECTION \_\_\_\_\_

Please indicate well location X.

ADDITIONAL INFORMATION

If more than one screen,  
show location of each on sketch.