

MISSISSIPPI DEPARTMENT OF ENVIRONMENTAL QUALITY

Office of Land and Water Resources

P. O. Box 10631
Jackson, MS 39289-0631
WATER WELL DRILLERS LOG

COUNTY WELL LOCATED TATE	
WELL NUMBER H 2164	PERMIT NUMBER HICKS WELL CO.
DATE WELL COMPLETED 12-16-98	NAME OF DRILLING FIRM HICKS WELL CO.

NAME & MAILING ADDRESS OF LANDOWNER Golden Timber			
P.O. Box 652			
Senatobia, MS 38668			
WELL LOCATION: SEC	TOWNSHIP	RANGE	
25	5	6	W
DISTANCE	DIRECTION	NEAREST TOWN	
1/2 Miles	W	Bar	
OTHER LANDMARK At the Big House			
WELL PURPOSE: <input checked="" type="radio"/> Home, <input type="radio"/> Irrigation, <input type="radio"/> Municipal, <input type="radio"/> Industrial, <input type="radio"/> Fish Pond, etc.			

PUMP DATA			
PUMP TYPE (Circle One): <input checked="" type="radio"/> Submersible, <input type="radio"/> Turbine, <input type="radio"/> Jet, <input type="radio"/> Flowing Well, Other (Describe) _____			
POWER TYPE (Circle One): <input checked="" type="radio"/> Electric, <input type="radio"/> Tractor, <input type="radio"/> Diesel, <input type="radio"/> Gasoline, <input type="radio"/> Butane, Other (Describe) _____ H/P 11/2			
Pump Capacity (GPM) 20	No. of Stages	Setting Depth 160	FT.
PUMP TEST			
Well yielded _____ GPM with a drawdown of no test ft. after _____ hours of pumping			

WELL DATA		
Well Depth 260	Casing Diameter (In.) 4	Casing Length (Ft.) 240
Type of Casing PVC	Hole Depth 260	Depth to Static Water Level 130

LOG DATA	
TYPE OF LOG RUN (Circle One): <input checked="" type="radio"/> No Log Run, <input type="radio"/> Electric, <input type="radio"/> Gamma Ray, <input type="radio"/> Density, <input type="radio"/> Sonic, <input type="radio"/> Neutron, Other (Describe) _____	
Name of Organization Running Log	

TYPE OF COMPLETION: (Circle One or More):
 Gravel Packed, Underreamed, Telescoped,
 Natural Development, Open Hole, Other
(Describe) _____

WELL GROUTED TO A DEPTH OF **3** FEET
Type Grout (circle one): Cement, Bentonite, or Mix

SCREEN DATA		
Diameter - Inches 4	Length - Feet 20	Slot Size - Inches 1014
Screen Type PVC slot	Depth to Bottom - Feet 240	

GEOLOGIC DATA (Office Use Only)			
Surface Elev.	Geologic Unit	Unit Thickness	Depth to Top
Subs. SWL	Date	Analysis	Aquifer Test
Driller's Remarks			
Top of Lap Pipe or Reduction in Casing			
FEET			
IF TELESCOPED OR MORE THAN ONE SCREEN: USE BACK PAGE			

DESCRIPTION OF FORMATIONS ENCOUNTERED	FROM	TO
Red Clay	0	10
Red Sand	10	50
White Sand & Clay	50	200
White Sand	200	260

FORMATIONS (Continued)	FROM	TO
RECEIVED		
DEC 28 1998		
Dept. of Environmental Quality		
Office of Land & Water Resources		
IF MORE SPACE IS NEEDED, USE BACK		

If well telescopes please sketch and show depths.


GROUND LEVEL

X			

SECTION 25

Please indicate well location X.

ADDITIONAL INFORMATION

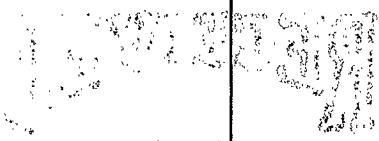

If more than one screen,
show location of each on sketch.