

**MISSISSIPPI DEPARTMENT OF ENVIRONMENTAL QUALITY**

Office of Land and Water Resources

P. O. Box 10631  
Jackson, MS 39289-0631  
**WATER WELL DRILLERS LOG**

COUNTY WELL LOCATED <i>LATE</i>	
WELL NUMBER <i>96</i>	CODED
<i>H 2171</i>	
DATE WELL COMPLETED <i>6-1-99</i>	

PERMIT NUMBER
NAME OF DRILLING FIRM <i>SMITH WELL DRILLING &amp; SEW.</i>

NAME & MAILING ADDRESS OF LANDOWNER <i>THE ROADWAY (TOMMY TEAL) POAGVILLE</i>		
WELL LOCATION: SEC	TOWNSHIP	RANGE
<i>15</i>	<i>T-5</i>	<i>N R-6 E</i>
DISTANCE	DIRECTION	NEAREST TOWN
_____ Miles	_____ of	_____
OTHER LANDMARK		
WELL PURPOSE: Home, Irrigation, Municipal, Industrial, Fish Pond, etc.		

<b>PUMP DATA</b>		
PUMP TYPE (Circle One): Submersible, Turbine, Jet, Flowing Well, Other (Describe) _____		
POWER TYPE (Circle One): Electric, Tractor, Diesel, Gasoline, Butane, Other (Describe) _____ H/P _____		
Pump Capacity (GPM)	No. of Stages	Setting Depth
	<i>CASIN</i>	_____ FT.
PUMP TEST <i>ONLY</i>		
Well yielded _____ GPM with a drawdown of _____ ft. after _____ hours of pumping		


<b>WELL DATA</b>		
Well Depth <i>140</i>	Casing Diameter (In.) <i>4</i>	Casing Length (Ft.) <i>130</i>
Type of Casing <i>PVC</i>	Hole Depth <i>140</i>	Depth to Static Water Level <i>40'</i>
TYPE OF COMPLETION: (Circle One or More): Gravel Packed, Underreamed, Telescoped, Natural Development, Open Hole, Other (Describe) <i>WASHED SAND</i>		
WELL GROUTED TO A DEPTH OF <i>10</i> FEET Type Grout (circle one): Cement, Bentonite, or Mix		

<b>LOG DATA</b>	
TYPE OF LOG RUN (Circle One): Electric, Gamma Ray, Density, Sonic, Neutron, Other (Describe) _____ No Log Run	
Name of Organization Running Log	

<b>SCREEN DATA</b>		
Diameter - Inches <i>4</i>	Length - Feet <i>10</i>	Slot Size - Inches <i>14 meshes</i>
Screen Type <i>PVC</i>	Depth to Bottom - Feet <i>140</i>	


<b>GEOLOGIC DATA (Office Use Only)</b>			
Surface Elev.	Geologic Unit	Unit Thickness	Depth to Top
Subs. SWL	Date	Analysis	Aquifer Test
Driller's Remarks			
Top of Lap Pipe or Reduction in Casing			
FEET			
IF TELESCOPED OR MORE THAN ONE SCREEN: USE BACK PAGE			

DESCRIPTION OF FORMATIONS ENCOUNTERED	FROM	TO
<i>Brown Clay</i>	<i>0</i>	<i>20</i>
<i>White Sand + Clay</i>	<i>20</i>	<i>60</i>
<i>White Sand</i>	<i>60</i>	<i>140</i>

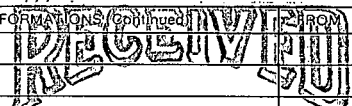 <b>JAN 07 1999</b>	
Dept. of Environmental Quality Office of Land & Water Resources	
IF MORE SPACE IS NEEDED, USE BACK	

If well telescopes please  
sketch and show depths.

GROUND LEVEL

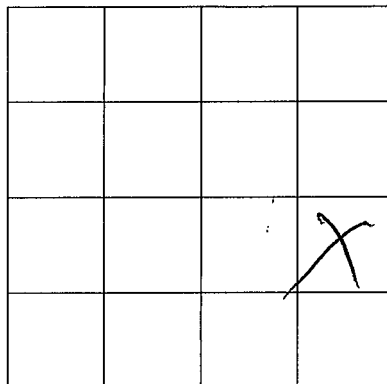

SECTION I-5

Please indicate well location X.

ADDITIONAL INFORMATION

If more than one screen,  
show location of each on sketch.