
TATE
J / /
5-19-71

## MISSISSIPPI BOARD OF WATER COMMISSIONERS 416 North State Street

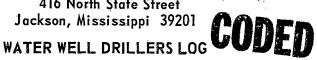

5-19 -71 5	IM~RENIX	TAVE	~ cens		
date well completed	firm name		county well located		
LANDOWNER: RABERT-ALEXA	description of for encountered	mations	from	to	
SENATOBIN, Miss (mailing address) WELL LOCATION:	DIRT SAND+ C SAND	CLAV	[D]	1.00 1.00 11.2	
sec. LAT S R B W  (distance) (direction) (neares					
WELL PURPOSE: リュハド (home, irrigation, municipal, indus	stria)				
WELL COMPLETION DATA:  (1) diameter (inches) 2/N/  (2) total depth (feet) 1/2  (3) static water level (feet) 80 b top of ground.  (4) casing ANN 108 (depth)  (size) if telescope see back.  (5) screen 1/2 (depth) (depth to to 1/2 (size) (material)  (6) pump (HP) (yield gpm)  EXECUTE (type power)  (7) electric log (yes or no)	ор)				
(organization running log) (8) how well bottom plugged ・	, JUI	N 22 1971			
DRILLERS REMARKS::		MISS, BD, OF VATER COMM.			

			•	
GROU	ND L	EVEL.		
	,			
1031				
ι	2"	GAW		
,	\	CALU		
3	174	G ZI -		
4	144	GALV Screen		
			,	
		3		

×		
	·	

SECTION 16

Please indicate well location X.

ADDITIONAL INFORMATION

If more than one screen, show locations of each on sketch.