

TATE

~~MISSISSIPPI~~  
J 5  
11-26-71

MISSISSIPPI  
BOARD OF WATER COMMISSIONERS  
416 North State Street  
Jackson, Mississippi 39201

CODED 371

WATER WELL DRILLERS LOG

MISS. BD. OF  
WATER COM.

11/26/

1971

G. and H. Well Co.

~~MISSISSIPPI~~ TATE

date well completed


firm name

county well located

LANDOWNER:	description of formations encountered	from	to
M. L. Smith			
Route 1 Box 172A, Como,	Red Clay	1	15
Mississippi	Red Clay	15	25
(mailing address)	Red Sand	26	35
WELL LOCATION:	" "	35	45
sec 30 T 6 N R 5 E	" "	45	55
7 miles NE of Como	" "	55	65
(distance) (direction) (nearest town)	" "	65	75
WELL PURPOSE: Home	" "	75	85
(home, irrigation, municipal, industrial)	" "	85	95
WELL COMPLETION DATA:	" "	95	105
(1) diameter (inches) 4 Inches	" "	105	115
(2) total depth (feet) 160	White Sand	115	125
(3) static water level (feet) 100 below top of ground.	" "	125	135
(4) casing Plastic 160 (material) (depth)	" "	136	145
(size) If telescope see back.	" "	145	155
(5) screen 5 ft. 6 ft. (length) (depth to top)	" CODED "	155	165
4 in. Gravel (size) (material)			
(6) pump 3/4 5GPM (HP) (yield gpm)			
Electric (type power)			
(7) electric log No (yes or no)			
(organization running log)			
(8) how well bottom plugged Cap			
DRILLERS REMARKS:			

If well telescopes please sketch and show depths.

GROUND LEVEL

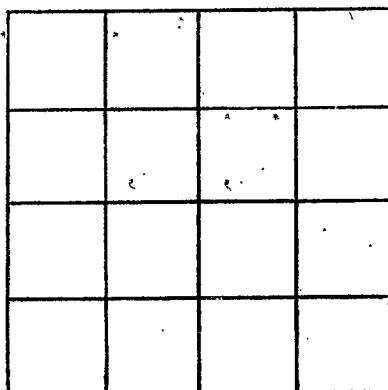

SECTION \_\_\_\_\_

Please indicate well location X.

ADDITIONAL INFORMATION

If more than one screen,  
show locations of each on sketch.