

Tate  
 J6  
 1-13-72

MISSISSIPPI  
 BOARD OF WATER COMMISSIONERS  
 416 North State Street  
 Jackson, Mississippi 39201

**CODED**

WATER WELL DRILLERS LOG

1/13/1972 G. and H. Well Co. Tate  
 date well completed firm name county well located

LANDOWNER:	description of formations encountered	from	to
Prentis Gipson	Red Sand	1	15
Route 5	Red Sand	15	20
Holly Springs, Mississippi	Red Sand	20	30
38635 (mailing address)	Red Sand	30	40
WELL LOCATION:	White Sand	40	50
sec. 24 T 5 N R 5 E	White Sand and Clay	50	60
17 miles EAST of SENATOBIA	White Sand	60	70
(distance) (direction) of (nearest town)	White Sand	70	80
WELL PURPOSE: HOME	White Sand	80	90
(home, irrigation, municipal, industrial)	White Sand	90	100
WELL COMPLETION DATA:	White Sand	100	110
(1) diameter (inches) 4 In.	White Sand	110	120
(2) total depth (feet) 210	White Sand	120	130
(3) static water level (feet) _____ below above top of ground.	White Sand	130	140
(4) casing Plastic 210 (material) (depth)	White Sand	140	150
_____ if telescope see back. (size)	White Sand	150	160
(5) screen 5 Ft. 6 Ft. (length) (depth to top)	White Sand	160	170
4 In. Gravel (size) (material)	White Sand	170	180
(6) pump 3/4 10 GPM (HP) (yield gpm)	White Sand	180	190
Electric 225 (type power)	White Sand	190	200
(7) electric log No (yes or no)	White Sand	200	210
(organization running log)			
(8) how well bottom plugged Cap			
DRILLERS REMARKS:			


**CODED**

JAN 18 1972

MISS. DE. OF WATER COM.

If well telescopes please sketch and show depths.

GROUND LEVEL

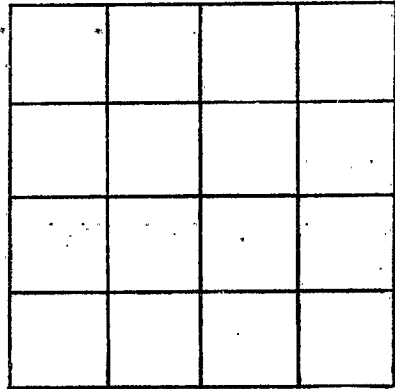

SECTION \_\_\_\_\_

Please indicate well location X.

ADDITIONAL INFORMATION

If more than one screen,  
show locations of each on sketch.