

**TATE**  
**J7**  
**1-22-72**

MISSISSIPPI  
 BOARD OF WATER COMMISSIONERS  
 416 North State Street  
 Jackson, Mississippi 39201

WATER WELL DRILLERS LOG

**CODED**

1/22/72

19

G. and H. Well Company

Tate

date well completed

firm name

county well located

LANDOWNER:	description of formations encountered	from	to
Willie H. Sandridge Route 5, Holly Springs, Miss. (mailing address)			
WELL LOCATION: sec. 12 T 5 N R 5 E 16 miles East of Senatobia (distance) (direction) (nearest town)	Red Sand	15	20
	White Sand	20	30
WELL PURPOSE: Home (home, irrigation, municipal, industrial)	White Sand	30	40
	White Sand	40	50
WELL COMPLETION DATA: (1) diameter (inches) 4 INch	White Sand	50	60
	White Sand	60	70
(2) total depth (feet) <del>160</del> 170	White Sand And Clay	70	80
(3) static water level (feet) 70 below above top of ground.	White Sand	80	90
(4) casing Plastic <del>160</del> 170 (material) (depth)	White Sand	90	100
(size) if telescope see back.	White Sand	100	110
(5) screen 5 ft. <del>160</del> ft. (length) (depth to top)	White Sand	110	120
4 in. Gravel (size) (material)	White Sand	120	130
(6) pump 3/4 10 GPM (HP) (yield gpm)	White Sand And Clay	130	140
Electric 220 (type power)	White Sand	140	150
(7) electric log No (yes or no)	White Sand	150	160
(organization running log)	White Sand	160	170
(8) how well bottom plugged Cap			
DRILLERS REMARKS:			


**CODED**

JAN 28 1972

MISS. BD. OF  
 WATER COM.

If well telescopes please  
sketch and show depths.

GROUND LEVEL

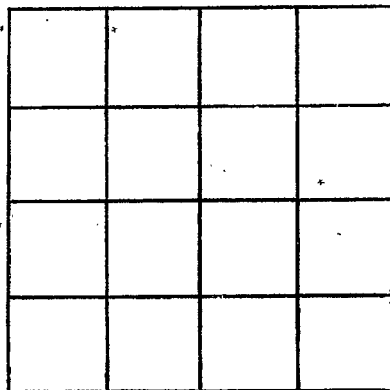

SECTION \_\_\_\_\_

Please indicate well location X.

ADDITIONAL INFORMATION

If more than one screen,  
show locations of each on sketch.