

**CODED**

MISSISSIPPI  
BOARD OF WATER COMMISSIONERS  
416 North State Street  
Jackson, Mississippi 39201

FEB 29 1972

**WATER WELL DRILLERS LOG**

MISS. BD. OF  
WATER COM.

TATE  
J8  
2-7-72

2/7/

1972

G. and H. Well Company

Tate

date well completed

firm name


county well located

LANDOWNER:	description of formations encountered	from	to	
George Hicks Route 1 Senatobia, Mississippi (mailing address)				Red Clay
WELL LOCATION: sec. <u>23</u> T <u>5</u> N R. <u>5</u> E (S) (W) <u>16</u> miles East of Senatobia (distance) (direction) (nearest town)	Red Sand	15	25	
	Red Sand	25	35	
	Red Sand	35	45	
	White Sand	45	55	
	White Sand	55	65	
	White Clay	65	75	
	White Clay	75	85	
	White Clay	85	95	
	White Clay	95	105	
	White Clay	105	115	
WELL PURPOSE: Home (home, irrigation, municipal, industrial)	White Clay	115	125	
	White Clay	125	135	
	White Clay & Sand	135	145	
	White Clay & Sand	145	155	
	White Clay & Sand	155	165	
	White Clay & Sand	165	175	
	White Clay & Sand	175	185	
	White Sand	185	195	
	White Sand	195	205	
	White Sand	205	215	
WELL COMPLETION DATA: (1) diameter (inches) <u>4 in</u> (2) total depth (feet) <u>255</u> (3) static water level (feet) <u>105</u> below above top of ground. (4) casing <u>Plastic</u> <u>255</u> <u>235'</u> (material) (depth) <u>255</u> <u>235'</u> (size) If telescope see back. (5) screen <u>20ft</u> <u>Slotted</u> (length) (depth to top) <u>4 in</u> <u>Slotted</u> (size) (material) (6) pump <u>3/4</u> <u>10GPM</u> (HP) (yield gpm) <u>Electric</u> <u>220</u> (type power) (7) electric log <u>No</u> (yes or no) (organization running log) (8) how well bottom plugged <u>Cap</u>	White Clay & Sand	215	225	
	White Clay & Sand	225	235	
	White Sand	235	245	
	White Sand	245	255	
DRILLERS REMARKS:				

**CODED**

If well telescopes please sketch and show depths.

GROUND LEVEL

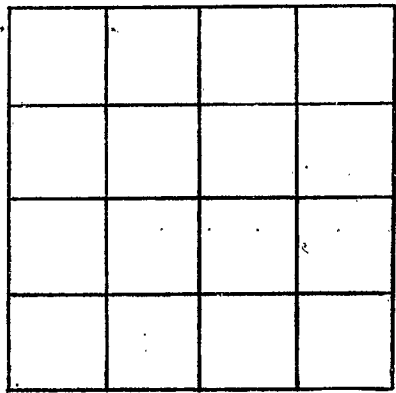

SECTION \_\_\_\_\_

Please indicate well location X.

ADDITIONAL INFORMATION

A series of 20 horizontal lines for providing additional information.

If more than one screen, show locations of each on sketch.