

CODED

MISSISSIPPI  
BOARD OF WATER COMMISSIONERS  
416 North State Street  
Jackson, Mississippi 39201

CODED

WATER WELL DRILLERS LOG

TATE  
~~\_\_\_\_\_~~

TATE  
510  
11-30-68

11-30 1968 Bob Smith  
date well completed firm name county well located

LANDOWNER: Les Fortune

description of formations encountered	from	to
<u>red clay</u>	<u>0</u>	<u>20</u>
<u>red gravel</u>	<u>20</u>	<u>40</u>
<u>white sand</u>	<u>40</u>	<u>200</u>

Wyatt, Miss.  
(mailing address)

WELL LOCATION:  
sec. 13 T 5 N R 5 E  
4 miles SE of Wyatt  
(distance) (direction) (nearest town)

WELL PURPOSE: None  
(home, irrigation, municipal, industrial)

- WELL COMPLETION DATA:
- (1) diameter (inches) 4
  - (2) total depth (feet) 200
  - (3) static water level (feet) 180 below above top of ground.
  - (4) casing Plastic 200  
(material) (depth)
  - (size) If telescope see back.
  - (5) screen 20 180  
(length) (depth to top)
  - 4 Plastic  
(size) (material)
  - (6) pump 34  
(HP) (yield gpm)
  - Electric  
(type power)
  - (7) electric log no  
(yes or no)

(organization running log)

(8) how well bottom plugged plugged

DRILLERS REMARKS:


good drilling

FEB 19 1969

MISS. BD. OF  
WATER COMM.

If well telescopes please sketch and show depths.

GROUND LEVEL

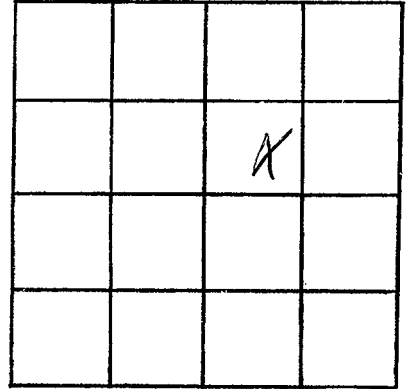

SECTION \_\_\_\_\_

Please indicate well location X.

ADDITIONAL INFORMATION

If more than one screen, show locations of each on sketch.