

Tate.  
 J 11  
 8-68

MISSISSIPPI  
 BOARD OF WATER COMMISSIONERS  
 416 North State Street  
 Jackson, Mississippi 39201

CODED

WATER WELL DRILLERS LOG

8-10 1968 Harris Bros. Tate  
 date well completed firm name county well located

LANDOWNER: Martha Anderson  
 Rte 1  
 Senatobia  
 (mailing address)

description of formations encountered	from	to
top soil	0	15
gravel + sand	15	45
clay + sand	45	100
Senatobia fine sand	100	125
CODED Coarse sand	125	140

WELL LOCATION:  
 sec 19 T 5 N R 5 E  
 14 miles E of Senatobia  
 (distance) (direction) (nearest town)

WELL PURPOSE: none  
 (home, irrigation, municipal, industrial)

WELL COMPLETION DATA:

(1) diameter (inches) 4"

(2) total depth (feet) 140

(3) static water level (feet) 90 below top of ground.

(4) casing Plaster, 133' (material) (depth)  
 if telescope see back.

(5) screen 7' length, 133' depth to top  
 #08, Plaster (size) (material)

(6) pump 3/4 HP, 7 yield gpm  
 Elec (type power)

(7) electric log no (yes or no)

(organization running log)

(8) how well bottom plugged back  
 shut

CODED


MAR 1 1969

MISS. BD. OF WATER COMMISSIONERS

DRILLERS REMARKS:

If well telescopes please sketch and show depths.

GROUND LEVEL

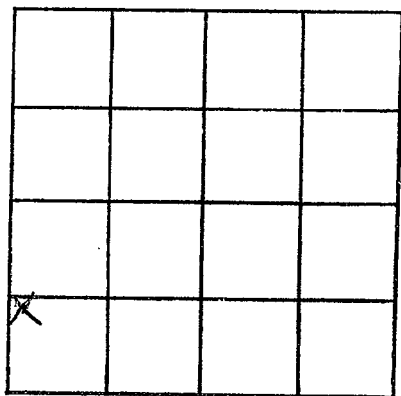

SECTION \_\_\_\_\_

Please indicate well location X.

ADDITIONAL INFORMATION

If more than one screen,  
show locations of each on sketch.