

CODED

MISSISSIPPI
BOARD OF WATER COMMISSIONERS
416 North State Street
Jackson, Mississippi 39201

WATER WELL DRILLERS LOG

Tate
J 14
10-68

10-1 1968 Harrison Tate
date well completed firm name county well located

LANDOWNER: Shirley Hyde

description of formations encountered

from to

pto 1

Senatobia
(mailing address)

top soil

0 15

w. clay

15 25

clay + sand

35 45

sand

45 130

WELL LOCATION:

sec 20 T S N R S E
1/8 miles S of Senatobia
(distance) (direction) (nearest town)

WELL PURPOSE: home + chnl.
(home, irrigation, municipal, industrial)

WELL COMPLETION DATA:

- (1) diameter (inches) 4"
- (2) total depth (feet) 130
- (3) static water level (feet) 40 ^{below}/_{above} top of ground
- (4) casing Plastic, 1 1/2'
(material) (depth)
4"
(size) If telescope see back.
- (5) screen 14', 1 1/2'
(length) (depth to top)
008, Plastic
(size) (material)
- (6) pump 2 30
(HP) (yield gpm)
elec
(type power)
- (7) electric log no
(yes or no)

(organization running log)

(8) how well bottom plugged well
shot

DRILLERS REMARKS:


CODED

MAR 1 1968

Miss. Bd. of
Water Comm.

If well telescopes please sketch and show depths.

GROUND LEVEL

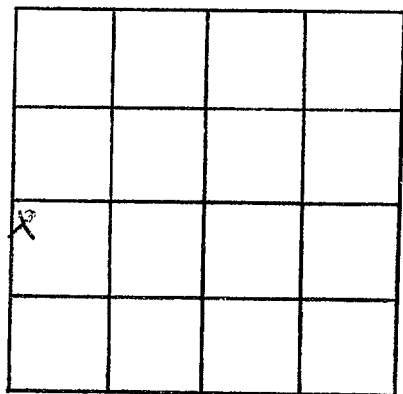

SECTION 20

Please indicate well location X.

ADDITIONAL INFORMATION

If more than one screen,
show locations of each on sketch.