

CODED

MISSISSIPPI  
BOARD OF WATER COMMISSIONERS  
416 North State Street  
Jackson, Mississippi 39201

WATER WELL DRILLERS LOG

TATE  
J 15  
17-6-69

July 6 1969 Bompa Well Co Tate  
date well completed firm name county well located

LANDOWNER:

Frank Bowden  
R#1 Senatobia, Miss  
(mailing address)

description of formations encountered

from to

Clay 0 20  
Sand 20 170

WELL LOCATION:

sec. 32 T 5 N R. 5 E  
4 miles South of Shafter  
(distance) (direction) (nearest town)

WELL PURPOSE: Home  
(home, irrigation, municipal, industrial)

WELL COMPLETION DATA:

- (1) diameter (inches) 4"
- (2) total depth (feet) 170 ft
- (3) static water level (feet) 120 below above top of ground.
- (4) casing 4" pvc, 16 ft  
(material) (depth)  
(size) If telescope see back.
- (5) screen 6 ft, 16 ft  
(length) (depth to top)  
4"  
(size) (material)
- (6) pump 3/4, 10  
(HP) (yield gpm)  
Elect  
(type power)
- (7) electric log \_\_\_\_\_  
(yes or no)

(organization running log)

(8) how well bottom plugged 4" Cap


DRILLERS REMARKS:

REC - 8 1969

MISS. Bd. OF  
WATER COMM.

If well telescopes please sketch and show depths.

GROUND LEVEL

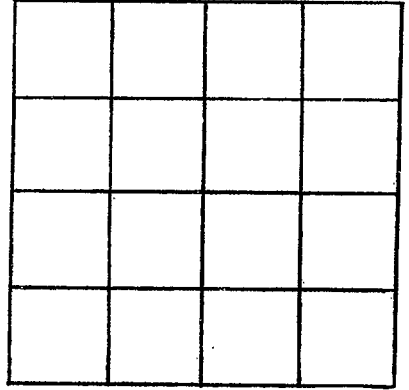

SECTION \_\_\_\_\_

Please indicate well location X.

ADDITIONAL INFORMATION

If more than one screen,  
show locations of each on sketch.