

TATE
 J 17
 7-2-69

MISSISSIPPI
 BOARD OF WATER COMMISSIONERS
 416 North State Street
 Jackson, Mississippi 39201

CODED

WATER WELL DRILLERS LOG

7-2 1969 Harris Bros Tate
 date well completed firm name county well located

LANDOWNER: H. S. Swift
 rte 1
 Senatobia
 (mailing address)

description of formations encountered	from	to
top soil	0	20
red sand	20	45
clay + sand	45	125
coarse sand	125	147

WELL LOCATION:
 sec 30 T-5 N R-5 E
 1 1/2 miles (distance) S (direction) of Senatobia (nearest town)

WELL PURPOSE: none
 (home, irrigation, municipal, industrial)


WELL COMPLETION DATA:
 (1) diameter (inches) 4"
 (2) total depth (feet) 140
 (3) static water level (feet) 80 ^{below} top of ground.
 (4) casing Plastic, 133 (material) (depth)
 4" (size) if telescope see back.
 (5) screen 7' (length), 133 (depth to top)
 008, Plastic (size) (material)
 (6) pump 3/4 (HP), 5 (yield gpm)
 elec (type power)
 (7) electric log no (yes or no)
 (organization running log)
 (8) how well bottom plugged back
 shaft

DRILLERS REMARKS:

DEC 22 1969
 MISS. BD. OF
 WATER COMM.

If well telescopes please sketch and show depths.

GROUND LEVEL

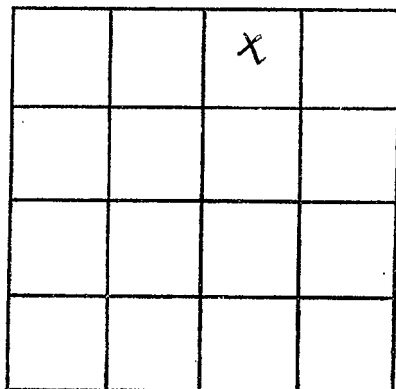

SECTION 30

Please indicate well location X.

ADDITIONAL INFORMATION

If more than one screen, show locations of each on sketch.