

TATE
8 18
8-16-69

MISSISSIPPI
BOARD OF WATER COMMISSIONERS
416 North State Street
Jackson, Mississippi 39201

CODED

WATER WELL DRILLERS LOG

8-16 1969 Harris Bros. Tate
date well completed firm name county well located

LANDOWNER: Hardin Bondage
Rte. 2
Coldwater
(mailing address)
WELL LOCATION:
sec. 04 T-5 N R-5 E
8 miles (S) of Indigo (W)
(distance) (direction) (nearest town)

Description of formations encountered	from	to
top soil	0	15
red sand	15	40
clay + sand	40	90
coarse sand	90	100

WELL PURPOSE: home
(home, irrigation, municipal, industrial)


WELL COMPLETION DATA:
(1) diameter (inches) 4
(2) total depth (feet) 100
(3) static water level (feet) 60 below top of ground.
(4) casing Plastics, 93" (material) (depth)
4" if telescope see back. (size)
(5) screen 7" 93" (length) (depth to top)
008 Plastics (size) (material)
(6) pump 3/4 7 (HP) (yield gpm)
abc. (type power)
(7) electric log no (yes or no)
(organization running log)
(8) how well bottom plugged well shot

DRILLERS REMARKS:

DEC 29 1969
MISS. BD. OF
WATER COMM.

If well telescopes please sketch and show depths.

GROUND LEVEL

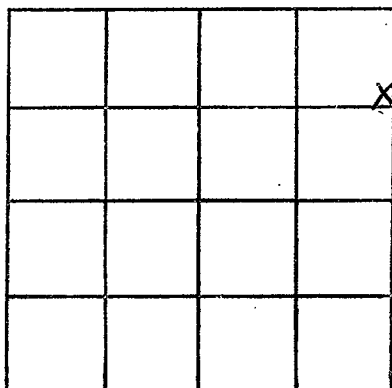

SECTION 04

Please indicate well location X.

ADDITIONAL INFORMATION

If more than one screen, show locations of each on sketch.