

CODED

MISSISSIPPI  
BOARD OF WATER COMMISSIONERS  
416 North State Street  
Jackson, Mississippi 39201

WATER WELL DRILLERS LOG

FATE
X 19
10-17-69

10-17 1969 Harris Bros. Fate  
 date well completed firm name county well located


LANDOWNER: Roosevelt Cathey pto 2. Coldwater (mailing address)	description of formations encountered	from	to
	top soil	0	65
	red sand	15	40
	clay + sand	40	90
	chert sand coarse sand	90	100
WELL LOCATION: sec. 1 T. 5 N. R. 6 E 4 miles SE of Independence (distance) (direction) (nearest town)			
WELL PURPOSE: home (home, irrigation, municipal, industrial)			
WELL COMPLETION DATA: (1) diameter (inches) 4 (2) total depth (feet) 100 (3) static water level (feet) 60 below top of ground. (4) casing Plastic, 9.3" (material) (depth) 4" (size) if telescope see back. (5) screen 7' 93" (length) (depth to top) 008, Plastic (size) (material) (6) pump 3/4 7 (HP) (yield gpm) elec. (type power) (7) electric log no (yes or no) (organization running log) (8) how well bottom plugged truck shot			
DRILLERS REMARKS:			

DEC 29 1969

MISS. BD. OF  
WATER COMM.

If well telescopes please sketch and show depths.

GROUND LEVEL

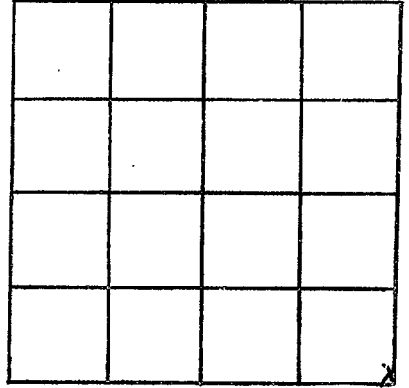

SECTION 1

Please indicate well location X.

ADDITIONAL INFORMATION

If more than one screen, show locations of each on sketch.