

TATE
J 21
7-20-70

MISSISSIPPI
BOARD OF WATER COMMISSIONERS
416 North State Street
Jackson, Mississippi 39201

CODED

WATER WELL DRILLERS LOG

7-20 1970 Harris Basin Tate
date well completed firm name county well located

LANDOWNER: Paul Hall
Pt. 1
Senatobia
(mailing address)

description of formations encountered	from	to
top soil	0	20
red sand	20	65
clay + sand	65	170
fine sand	170	190
coarse sand	190	214

WELL LOCATION:
sec 22 T 5 N R 5 E
1 miles W of Vevette
(distance) (direction) (nearest town)

WELL PURPOSE: none
(home, irrigation, municipal, industrial)

- WELL COMPLETION DATA:
- (1) diameter (inches) 4
 - (2) total depth (feet) 214
 - (3) static water level (feet) 100 ^{below} top of ground
 - (4) casing Plastic, 200 (material) (depth)
4 (size) if telescope see back.
 - (5) screen 14 (length), 200 (depth to top)
008, Plastic (size) (material)
 - (6) pump 3/4 (HP), 10 (yield gpm)
elec. (type power)
 - (7) electric log no (yes or no)

CODED

(organization running log)
(8) how well bottom plugged truck
not


DRILLERS REMARKS:

NOV 12 1970

MISS. BD. OF
WATER COMMISSIONERS

If well telescopes please sketch and show depths.

GROUND LEVEL

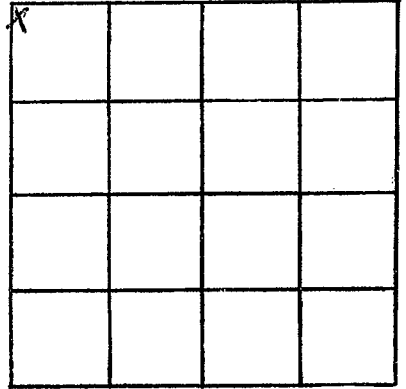

SECTION 22

Please indicate well location X.

ADDITIONAL INFORMATION

If more than one screen, show locations of each on sketch.