

TATE
 J 22
 7-25-70

MISSISSIPPI
 BOARD OF WATER COMMISSIONERS
 416 North State Street
 Jackson, Mississippi 39201

CODED

WATER WELL DRILLERS LOG

7-25 19 70 Harrison Tate
 date well completed firm name county well located

LANDOWNER: Edell Daves
pt. 1
Senatobia
 (mailing address)

description of formations encountered	from	to
top soil	0	15
red sand	15	40
clay + fine sand	40	120
loose sand	120	140

WELL LOCATION:
 sec. 30 T. 5 N. R. 5 E.
1/4 miles S of Tryston
 (distance) (direction) (nearest town)

WELL PURPOSE: name
 (home, irrigation, municipal, industrial)

- WELL COMPLETION DATA:
- (1) diameter (inches) 4
 - (2) total depth (feet) 140
 - (3) static water level (feet) 80 ^{below} above top of ground.
 - (4) casing Plastic, 133,
 (material) (depth)
4 If telescope see back.
 (size)
 - (5) screen 7', 133
 (length) (depth to top)
008, Plastic
 (size) (material)
 - (6) pump 3/4 10
 (HP) (yield gpm)
elec.
 (type power)
 - (7) electric log no
 (yes or no)

CODED

(organization running log)

(8) how well bottom plugged back
short


NOV 12 1970

DRILLERS REMARKS:

MSS. 59. 07

If well telescopes please sketch and show depths.

GROUND LEVEL

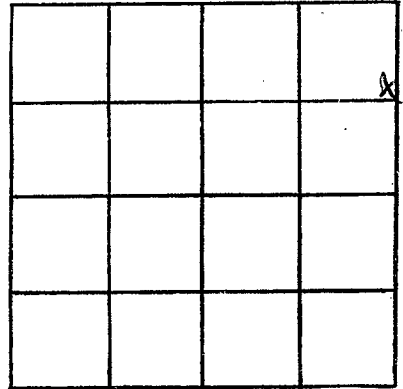

SECTION 30

Please indicate well location X.

ADDITIONAL INFORMATION

If more than one screen,
show locations of each on sketch.