

TATE

~~REAR WALL~~
J23
10-21-70

MISSISSIPPI
BOARD OF WATER COMMISSIONERS
416 North State Street
Jackson, Mississippi 39201

CODED

WATER WELL DRILLERS LOG

10-21-1970 date well completed
Bumpas Well Co. firm name
Dean Post Bumpas county well located

LANDOWNER:

John F. Carter
RT-1-Box 138, A
Senatobia, Miss.
(mailing address)

description of formations encountered

from to
0 20
20 60
30 90
90 160

WELL LOCATION:

sec. 32 T 5 N R 5 E
0 miles South of Senatobia
(distance) (direction) (nearest town)

WELL PURPOSE:

Dwellings
(home, irrigation, municipal, industrial)

WELL COMPLETION DATA:

- (1) diameter (inches) 4"
- (2) total depth (feet) 160 feet
- (3) static water level (feet) 120 below top of ground.
- (4) casing PVC 160 feet (material) (depth)
(size) If telescope see back.
- (5) screen 6 ft. 154 feet (length) (depth to top)
4" gravel well (size) (material)
- (6) pump 3/4 HP 10 (type power) (yield gpm)
- (7) electric log elect. (yes or no)

CODED

(organization running log)

- (8) how well bottom plugged 4" cap.


NOV 13 1970

MISS. BD. OF
WATER COMM.

DRILLERS REMARKS:

If well telescopes please sketch and show depths.

GROUND LEVEL

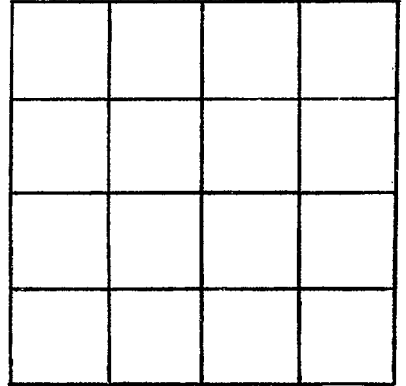

SECTION _____

Please indicate well location X.

ADDITIONAL INFORMATION

If more than one screen, show locations of each on sketch.