

TATE  
~~MISSISSIPPI~~  
 J 24  
 12-11-70

MISSISSIPPI  
 BOARD OF WATER COMMISSIONERS  
 416 North State Street  
 Jackson, Mississippi 39201

**CODED**

WATER WELL DRILLERS LOG

12-11-70 date well completed  
 70 Bumpas Wells firm name  
 Marshall county well located  
 Dean & Kent

LANDOWNER:

Henry Lee Floot  
 Rt. 5 Holly Springs, W. Va.  
 (mailing address)

description of formations encountered

from

to

clay	0	30
sand	30	200

WELL LOCATION:

sec. 25 T. 5 N R. 5 E  
 3 miles South of Weyant  
 (distance) (direction) (nearest town)

WELL PURPOSE: Drinking  
 (home, irrigation, municipal, industrial)

WELL COMPLETION DATA:

- (1) diameter (inches) 4"
- (2) total depth (feet) 200 feet
- (3) static water level (feet) 150 below above top of ground.
- (4) casing PVC 200 feet  
 (material) (depth)
- (size) If telescope see back.
- (5) screen 6 ft. 194 feet  
 (length) (depth to top)
- 4" gravel waf.  
 (size) (material)
- (6) pump 3/4 10  
 (HP) (yield gpm)

**CODED**

(type power)  
 (7) electric log test  
 (yes or no)

(organization running log)

(8) how well bottom plugged 4" caps


JAN 7 1971

DRILLERS REMARKS:

MISS. BD. OF  
 WATER COMMISSIONERS

If well telescopes please sketch and show depths.

GROUND LEVEL

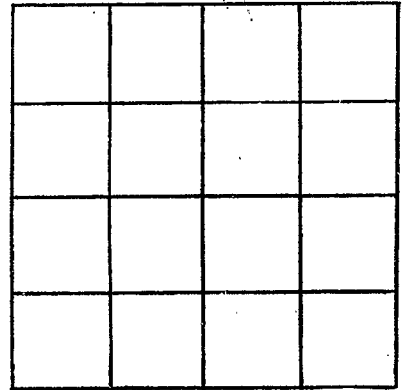

SECTION \_\_\_\_\_

Please indicate well location X.

ADDITIONAL INFORMATION

If more than one screen,  
show locations of each on sketch.