

**CODED**

MISSISSIPPI  
BOARD OF WATER COMMISSIONERS  
416 North State Street  
Jackson, Mississippi 39201

**WATER WELL DRILLERS LOG**

TATE  
J25  
12-15-71

12-15 1971 Harris Bros. Tate  
date well completed firm name county well located

| LANDOWNER   | description of formations encountered | from       | to         |
|---|---------------------------------------|------------|------------|
| <u>Randall</u><br><u>Hoopin</u><br><u>Rt. 1 Senatobia</u><br>(mailing address)  |                                       |            |            |
|   | <u>red sand</u>                       | <u>15</u>  | <u>50</u>  |
| WELL LOCATION:<br>sec. <u>19</u> T <u>5</u> N R. <u>5</u> E<br><u>dn Hustera</u><br>(distance) miles (direction) of (nearest town)  | <u>clay &amp; sand</u>                | <u>50</u>  | <u>175</u> |
|   | <u>fine sand</u>                      | <u>175</u> | <u>190</u> |
| WELL PURPOSE:<br>(home, irrigation, municipal, industrial)  | <u>course sand</u>                    | <u>190</u> | <u>210</u> |
| WELL COMPLETION DATA:<br>(1) diameter (inches) <u>4</u><br>(2) total depth (feet) <u>210</u><br>(3) static water level (feet) <u>120</u> <sup>below</sup> above top of ground.<br>(4) casing <u>Plastic</u> , <u>196</u><br>(material) (depth)<br><u>4</u> if telescope see back.<br>(size)<br>(5) screen <u>14</u> , <u>196</u><br>(length) (depth to top)<br><u>008</u> , <u>Plastic</u><br>(size) (material)<br>(6) pump <u>3/4</u> , <u>10</u><br>(HP) (yield gpm)<br><u>elec.</u><br>(type power)<br>(7) electric log <u>NO</u><br>(yes or no)<br>(organization running log)<br>(8) how well bottom plugged <u>Solid</u> |                                       |            |            |
| DRILLERS REMARKS:   |                                       |            |            |


**CODED**

**AUG - 7 1972**

MISS. BD. OF  
WATER COMM.

If well telescopes please sketch and show depths.

GROUND LEVEL

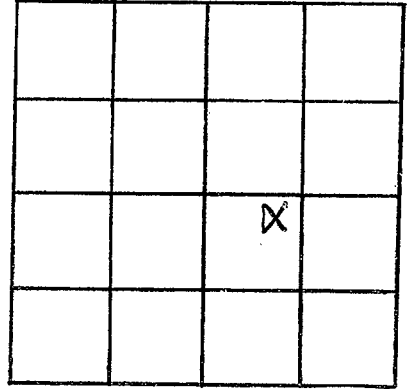

SECTION 19

Please indicate well location X.

ADDITIONAL INFORMATION

If more than one screen, show locations of each on sketch.