

TATE  
J 27  
7-15-72

MISSISSIPPI  
BOARD OF WATER COMMISSIONERS  
416 North State Street  
Jackson, Mississippi 39201

CODED

WATER WELL DRILLERS LOG

7-15 1972 Harris Bros. Tate  
date well completed firm name county well located

LANDOWNER: Asian Moore  
Rt 2  
Coldwater  
(mailing address)

WELL LOCATION:  
sec. 17 T 5 N R 5 E  
1 miles N of Pryatt  
(distance) (direction) (nearest town)

WELL PURPOSE: none  
(home, irrigation, municipal, industrial)

WELL COMPLETION DATA:  
(1) diameter (inches) 4  
(2) total depth (feet) 210  
(3) static water level (feet) 120 (below above top of ground)  
(4) casing Plastic, 196 (material) (depth)  
4 (size) if telescope see back.  
(5) screen 14, 196 (length) (depth to top)  
008, Plastic (size) (material)  
(6) pump 3/4, 7 (HP) (yield gpm)  
elec. (type power)  
(7) electric log no (yes or no)  
(organization running log)  
(8) how well bottom plugged sealed

description of formations encountered	from	to
top soil	0	20
red sand	20	65
fine sand + clay	65	140
fine sand	140	180
Coarse sand	180	210


OCT 18 1972

DRILLERS REMARKS:

MISS. BD. OF  
WATER COMMISSIONERS

If well telescopes please sketch and show depths.

GROUND LEVEL

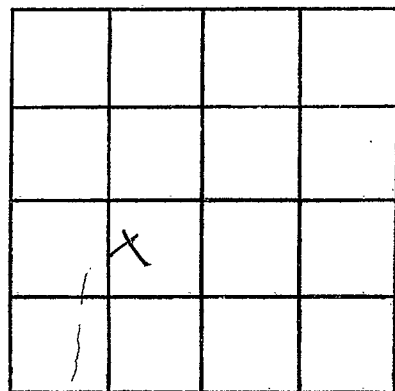

SECTION 17

Please indicate well location X.

ADDITIONAL INFORMATION

If more than one screen,  
show locations of each on sketch.