

TATE
 J 28
 2-5-73

MISSISSIPPI
 BOARD OF WATER COMMISSIONERS
 416 North State Street
 Jackson, Mississippi 39201

CODED

WATER WELL DRILLERS LOG

2-5-73 19 Hicks Bros Well Co. Tate
 date well completed firm name county well located

LANDOWNER: J. T. Williams
 Route 1 Senatobia, Miss. 38668
 (mailing address)

description of formations encountered	from	to
Red Clay	0	15
Red Sand	15	110
White Sand & Clay	110	120
White Sand	120	130
White Sand	130	170

WELL LOCATION:
 sec 20 T 5 N R 5 E
 1.5 miles East of Senatobia
 (distance) (direction) (nearest town)

WELL PURPOSE:
 (home, irrigation, municipal, industrial)

WELL COMPLETION DATA:

(1) diameter (inches) 4 in.
 (2) total depth (feet) 170 ft
 (3) static water level (feet) 100 ft below top of ground.
 (4) casing Plastic, 170 (material) (depth)
 (size) If telescope see back.
 (5) screen 5 ft, 120 ft (length) (depth to top)
 4 in, gravel (size) (material)
 (6) pump 3/4 10 GPM (HP) (yield gpm)
 Electric (type power)
 (7) electric log ~~yes~~ no (yes or no)
 (organization running log)
 (8) how well bottom plugged Cap


CODED

SEP 27 1973

DRILLERS REMARKS:

If well telescopes please sketch and show depths.

GROUND LEVEL

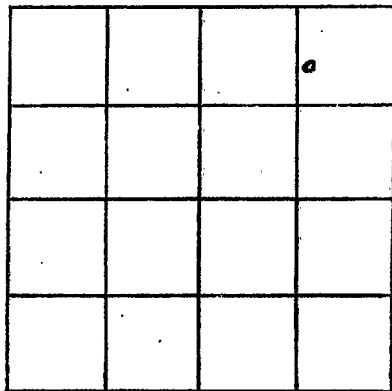

SECTION _____

Please indicate well location X.

ADDITIONAL INFORMATION

If more than one screen,
show locations of each on sketch.