

TATE  
J 29  
2-22-73

MISSISSIPPI  
BOARD OF WATER COMMISSIONERS  
416 North State Street  
Jackson, Mississippi 39201

**CODED**

WATER WELL DRILLERS LOG

2-22-73 19 Hicks Bros. Well Co. Jate  
date well completed firm name county well located

Secoy (Gullie) Dean  
LANDOWNER description of formations encountered from to  
Route 2, Coldwater, Miss. 38635  
Red Clay & Sand 0 60  
White Sand 60 140  
(mailing address)

WELL LOCATION:  
sec. 4 T 5 N R. 5 E  
17 miles SE of Coldwater  
(distance) (direction) (nearest town)

WELL PURPOSE: Home  
(home, irrigation, municipal, industrial)

- WELL COMPLETION DATA:
- (1) diameter (inches) 4 inch
  - (2) total depth (feet) 140
  - (3) static water level (feet) 47 below above top of ground.
  - (4) casing Plastic, 140  
(material) (depth)
  - \_\_\_\_\_ if telescope see back.  
(size)
  - (5) screen 4 ft 100  
(length) (depth to top)
  - 4 in. Drum  
(size) (material)
  - (6) pump 3/4 10 G PM  
(HP) (yield gpm)
  - Electric  
(type power)
  - (7) electric log No  
(yes or no)
  - \_\_\_\_\_ (organization running log)
  - (8) how well bottom plugged Cap


**CODED**

FEB 27 1973

DRILLERS REMARKS:

If well telescopes please sketch and show depths.

GROUND LEVEL

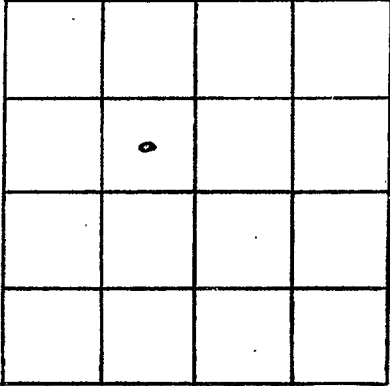

SECTION \_\_\_\_\_

Please indicate well location X.

ADDITIONAL INFORMATION

If more than one screen, show locations of each on sketch.