

TATE
J 31
3-5-73

MISSISSIPPI
BOARD OF WATER COMMISSIONERS
416 North State Street
Jackson, Mississippi 39201

CODT

WATER WELL DRILLERS LOG


3-5-1973 date well completed Bob Smith firm name Tate county well located

LANDOWNER:	description of formations encountered	from	to
Clay Whitehead			
Betty, Miss. (mailing address)	Red sand	10	60
WELL LOCATION:	White sand	60	150
sec. <u>5</u> T. <u>5</u> N. R. <u>5</u> E.			
<u>1/2</u> miles <u>South</u> of <u>Bett</u>			
(distance) (direction) (nearest town)			
WELL PURPOSE: <u>None</u>			
(home, irrigation, municipal, industrial)			
WELL COMPLETION DATA:			
(1) diameter (inches) <u>4</u>			
(2) total depth (feet) <u>160</u>			
(3) static water level (feet) <u>80</u> below top of ground.			
(4) casing <u>Plastic 160</u>			
(material) (depth)			
(size) if telescope see back.			
(5) screen <u>20</u> <u>140</u>			
(length) (depth to top)			
<u>4</u> <u>Plastic</u>			
(size) (material)			
(6) pump <u>1/2</u> <u>10</u>			
(HP) (yield gpm)			
<u>Electric</u>			
(type power)			
(7) electric log <u>no</u>			
(yes or no)			
(organization running log)			
(8) how well bottom plugged <u>slugged</u>			
DRILLERS REMARKS:			

APR 2 5 1973

If well telescopes please sketch and show depths.

GROUND LEVEL

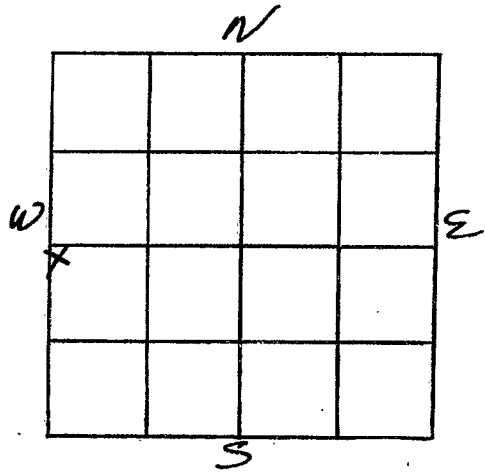

SECTION 5

Please indicate well location X.

ADDITIONAL INFORMATION

If more than one screen,
show locations of each on sketch.