

Loche

TATE
J 32
5-30-73

MISSISSIPPI
BOARD OF WATER COMMISSIONERS
416 North State Street
Jackson, Mississippi 39201

CODED

WATER WELL DRILLERS LOG *Late*

5-30-1973 *Blacksboro, Mo.* ~~Marshall~~
date well completed firm name county well located

LANDOWNER: *Cathy W. Loche*
Loche-3493 W. Fern
Memphis, Tenn.
(mailing address)

description of formations encountered	from	to
<i>Red Clay</i>	<i>0</i>	<i>15</i>
<i>Red sand</i>	<i>15</i>	<i>90</i>
<i>White sand</i>	<i>90</i>	<i>210</i>

WELL LOCATION:
sec. *22* T. *5* N. R. *5* E
15 miles *E* of *Senatobia*
(distance) (direction) (nearest town)

WELL PURPOSE: *Home*
(home, irrigation, municipal, industrial)

WELL COMPLETION DATA:
(1) diameter (inches) *4 1/2*
(2) total depth (feet) *210*
(3) static water level (feet) *118* below above top of ground.
(4) casing *Plastic*, *210*,
(material) (depth)

CODED

(size) If telescope see back.
(5) screen *4ft.*, *206*
(length) (depth to top)
4 1/2, *St. Paul*
(size) (material)
(6) pump *3/4*, *10 x 1 1/2*
(HP) (yield gpm)
Electric, *230*
(type power)
(7) electric log *no*
(yes or no)

(organization running log)
(8) how well bottom plugged *Cap*


JUN 21 1973

DRILLERS REMARKS:

MISS. BD. OF
WATER COMM.

If well telescopes please sketch and show depths.

GROUND LEVEL

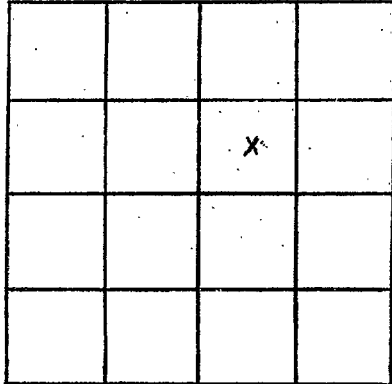

SECTION *22*

Please indicate well location X.

ADDITIONAL INFORMATION

Lined area for additional information.

If more than one screen, show locations of each on sketch.