

CODED

TATE
J 33
7-17-73

MISSISSIPPI
BOARD OF WATER COMMISSIONERS
416 North State Street
Jackson, Mississippi 39201

WATER WELL DRILLERS LOG

7-17-73 date well completed 73 Ships Bay Wells firm name Tate county well located

LANDOWNER: M. E. Berry
5709 Madd Point Rd
Southaven, Miss
(mailing address)

description of formations encountered	from	to
<u>Red Clay</u>	<u>0</u>	<u>15</u>
<u>Red Sand</u>	<u>15</u>	<u>75</u>
<u>White Sand + Clay</u>	<u>75</u>	<u>135</u>
<u>White Sand</u>	<u>135</u>	<u>190</u>

WELL LOCATION:
sec. 9 T. 5 N. R. 5 E.
16 miles SE of Senatobia
(distance) (direction) (nearest town)

WELL PURPOSE: Home
(home, irrigation, municipal, industrial)

WELL COMPLETION DATA:

- (1) diameter (inches) 4"
- (2) total depth (feet) 190
- (3) static water level (feet) 121 below above top of ground.
- (4) casing PVC 190
(material) (depth)
 if telescope see back.
(size)
- (5) screen 4ft 186
(length) (depth to top)
4" Shavel
(size) (material)
- (6) pump 3/4 106 GPM
(HP) (yield gpm)
Electric 250
(type power)
- (7) electric log NO
(yes or no)
- (organization running log)
- (8) how well bottom plugged Cap


CODED

DRILLERS REMARKS:

JUL 25 1973

If well telescopes please
sketch and show depths.

GROUND LEVEL

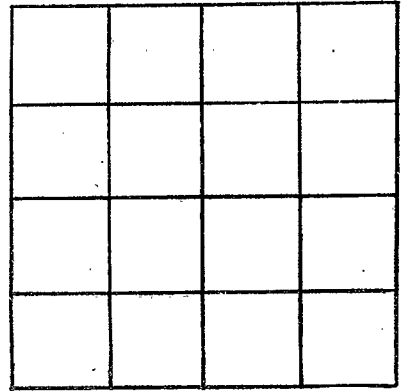

SECTION _____

Please indicate well location X.

ADDITIONAL INFORMATION

If more than one screen,
show locations of each on sketch.