

TATE
J37
5-8-73

MISSISSIPPI
BOARD OF WATER COMMISSIONERS
416 North State Street
Jackson, Mississippi 39201


WATER WELL DRILLERS LOG

5-8 1973 Harris **CODED** Tate
date well completed firm name county well located

LANDOWNER:	description of formations encountered	from	to	
J. M. Latimer, Jr. Rt. 3 Senatobia (mailing address)	top soil	0	15	
	red sand & clay	15	50	
	fine w. sand & clay	50	110	
	Coarse sand	110	130	
WELL LOCATION: sec. 8 T. 5 N R. 5 E 2 miles N of Theatria (distance) (direction) (nearest town)				
WELL PURPOSE: home (home, irrigation, municipal, industrial)				
WELL COMPLETION DATA: (1) diameter (inches) 4 (2) total depth (feet) 130 (3) static water level (feet) 80 ^{below} above top of ground. (4) casing Plastic, 123, 4 (material) (depth) (size) If telescope see back. (5) screen 7, 123 (length) (depth to top) 008, Plastic (size) (material) (6) pump 3/4, 10 (HP) (yield gpm) elec. (type power) (7) electric log NO (yes or no) (organization running log) (8) how well bottom plugged sealed	<p>CODED</p>			
DRILLERS REMARKS:				

If well telescopes please
sketch and show depths.

GROUND LEVEL

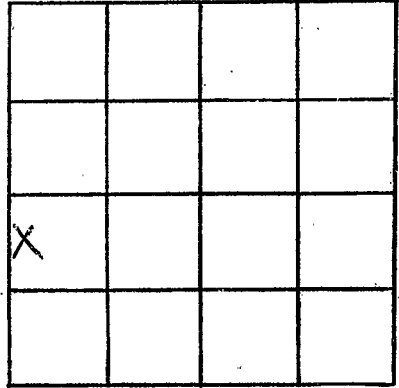

SECTION 8

Please indicate well location X.

ADDITIONAL INFORMATION

If more than one screen,
show locations of each on sketch.